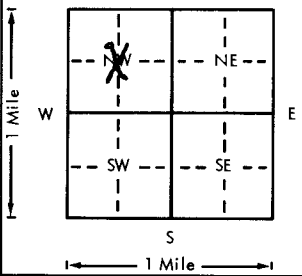


USE TYPEWRITER OR BALL
POINT PEN-PRESS FIRMLY,
PRINT CLEARLY.

WATER WELL RECORD
KSA 82a-1201-1215

Kansas Department of Health and
Environment-Division of Environment
(Water well Contractors)
Topeka, Kansas 66620

1. Location of well:		County Pawnee	Fraction 1/4 1/4 CNW/4	Section number 10	Township number T 22 S R 15 NW
2. Distance and direction from nearest town or city: 15 7 E Street address of well location if in city: Larned, KS			3. Owner of well: Stan Compton R.R. or street: R2, Larned, KS City, state, zip code:		
4. Locate with "X" in section below: 			Sketch map:		
5. Type and color of material			From	To	6. Bore hole dia. 28 in. Completion date 1-25-77 Well depth 180 ft.
Top Soil - Clay			0	23	7. <input type="checkbox"/> Cable tool <input type="checkbox"/> Rotary <input type="checkbox"/> Driven <input type="checkbox"/> Dug <input type="checkbox"/> Hollow rod <input type="checkbox"/> Jetted <input type="checkbox"/> Bored <input checked="" type="checkbox"/> Reverse rotary
Sand - Gravel			23	67	8. Use: <input type="checkbox"/> Domestic <input type="checkbox"/> Public supply <input type="checkbox"/> Industry <input checked="" type="checkbox"/> Irrigation <input type="checkbox"/> Air conditioning <input type="checkbox"/> Stock <input type="checkbox"/> Lawn <input type="checkbox"/> Oil field water <input type="checkbox"/> Other
Clay			67	102	9. Casing: Material Steel Height: <input checked="" type="radio"/> Above or below Threaded <input type="checkbox"/> Welded <input type="checkbox"/> Surface 24 in. RMP <input type="checkbox"/> PVC <input type="checkbox"/> Weight <input type="checkbox"/> lbs./ft. Dia. 16 in. to 180 ft. depth Wall Thickness: inches or Dia. <input type="checkbox"/> in. to <input type="checkbox"/> ft. depth gage No. 3/16"
Sand - clay			102	132	10. Screen: Manufacturer's name Doerr Type Steel Dia. 16" Slot/gauze 1/8 Length 40' Set between 140 ft. and 180 ft. <input type="checkbox"/> ft. and <input type="checkbox"/> ft. Gravel pack? <input checked="" type="checkbox"/> Size range of material 1/8-3/4"
Sand - Gravel			132	180	11. Static water level: <input type="checkbox"/> mo./day/yr. 30 ft. below land surface Date 1-25-77
					12. Pumping level below land surfaces: <input type="checkbox"/> ft. after <input type="checkbox"/> hrs. pumping <input type="checkbox"/> g.p.m. 71 ft. after 4 hrs. pumping 1400 g.p.m. Estimated maximum yield 1600 g.p.m.
					13. Water sample submitted: <input type="checkbox"/> mo./day/yr. Yes <input checked="" type="checkbox"/> No Date <input type="checkbox"/>
					14. Well head completion: <input type="checkbox"/> Pitless adapter 24 inches above grade
					15. Well grouted? <input checked="" type="checkbox"/> With: <input checked="" type="checkbox"/> Neat cement <input type="checkbox"/> Bentonite <input type="checkbox"/> Concrete Depth: From 0 ft. to 10 ft.
					16. Nearest source of possible contamination: NONE ft. <input type="checkbox"/> Direction <input type="checkbox"/> Type <input type="checkbox"/> Well disinfected upon completion? <input type="checkbox"/> Yes <input type="checkbox"/> No
					17. Pump: <input type="checkbox"/> Not installed Manufacturer's name Boulds Model number 145 HP 60 Volts 430 Length of drop pipe 120 ft. capacity 1400 g.p.m. Type: <input type="checkbox"/> Submersible <input checked="" type="checkbox"/> Turbine <input type="checkbox"/> Jet <input type="checkbox"/> Reciprocating <input type="checkbox"/> Centrifugal <input type="checkbox"/> Other
(Use a second sheet if needed)					
18. Elevation:		19. Remarks:		20. Water well contractor's certification: This well was drilled under my jurisdiction and this report is true to the best of my knowledge and belief. Kelly's Water Well Ser 186 Business name R2 Great Bend, KS License No. 150 Address R2 Great Bend, KS Signed Kelly Price Date 4-20-77 Authorized representative	

Forward the white, blue and pink copies to the Department of Health and Environment

Form WWC-5