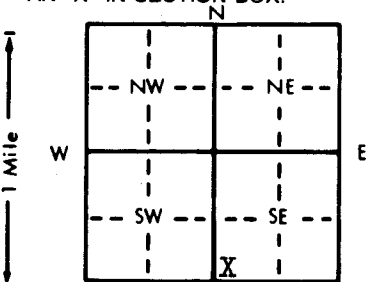


1 LOCATION OF WATER WELL:		Fraction		Section Number		Township Number		Range Number	
County: Pawnee		SW 1/4 SW 1/4 SE 1/4		29		T 22 S		R 15W E/W	
Distance and direction from nearest town or city street address of well if located within city?									
5 S, 5 1/2 E of Iarned, Kansas									
2 WATER WELL OWNER: Marlin Barstow					Union Drilling				
RR#, St. Address, Box #: Route 2					422 Union Center				
City, State, ZIP Code: Macksville, Ks. 67557					Wichita, Ks. 67202				
					Board of Agriculture, Division of Water Resources				
					Application Number: Unknown				
3 LOCATE WELL'S LOCATION WITH AN "X" IN SECTION BOX:					4 DEPTH OF COMPLETED WELL a 62 ft. ELEVATION: Unknown				
					Depth(s) Groundwater Encountered 1. 25 ft. 2. ft. 3. ft.				
					WELL'S STATIC WATER LEVEL 25 ft. below land surface measured on mo/day/yr 12/3/82				
					Pump test data: Well water was ft. after hours pumping gpm				
					Est. Yield 60 gpm Well water was ft. after hours pumping gpm				
Bore Hole Diameter 8 in. to 62 ft., and in. to ft.									
WELL WATER TO BE USED AS:					5 Public water supply 8 Air conditioning 11 Injection well				
1 Domestic 3 Feedlot 6 Oil field water supply 9 Dewatering 12 Other (Specify below)									
2 Irrigation 4 Industrial 7 Lawn and garden only 10 Observation well									
Was a chemical/bacteriological sample submitted to Department? Yes No; If yes, mo/day/yr sample was submitted					Water Well Disinfected? Yes No				
5 TYPE OF BLANK CASING USED:									
1 Steel 3 RMP (SR) 5 Wrought iron 8 Concrete tile CASING JOINTS: Glued Clamped									
2 PVC 4 ABS 6 Asbestos-Cement 9 Other (specify below) Welded									
7 Fiberglass Threaded									
Blank casing diameter 5 in. to 42 ft., Dia in. to ft., Dia in. to ft.									
Casing height above land surface 12 in., weight 2.8 lbs./ft. Wall thickness or gauge No. Sch. 40									
TYPE OF SCREEN OR PERFORATION MATERIAL:									
1 Steel 3 Stainless steel 5 Fiberglass 8 RMP (SR) 10 Asbestos-cement									
2 Brass 4 Galvanized steel 6 Concrete tile 9 ABS 11 Other (specify)									
12 None used (open hole)									
SCREEN OR PERFORATION OPENINGS ARE:									
1 Continuous slot 3 Mill slot 5 Gauzed wrapped 8 Saw cut 11 None (open hole)									
2 Louvered shutter 4 Key punched 6 Wire wrapped 9 Drilled holes									
7 Torch cut 10 Other (specify)									
SCREEN-PERFORATED INTERVALS: From 42 ft. to 62 ft., From ft. to ft.									
From ft. to ft., From ft. to ft.									
GRAVEL PACK INTERVALS: From 10 ft. to 62 ft., From ft. to ft.									
From ft. to ft., From ft. to ft.									
6 GROUT MATERIAL:									
1 Neat cement 2 Cement grout 3 Bentonite 4 Other									
Grout Intervals: From 0 ft. to 10 ft., From ft. to ft., From ft. to ft.									
What is the nearest source of possible contamination:									
1 Septic tank 4 Lateral lines 7 Pit privy 10 Livestock pens 14 Abandoned water well									
2 Sewer lines 5 Cess pool 8 Sewage lagoon 11 Fuel storage 15 Oil well/Gas well									
3 Watertight sewer lines 6 Seepage pit 9 Feedyard 12 Fertilizer storage 16 Other (specify below)									
13 Insecticide storage									
Direction from well? South How many feet? 60									
FROM TO LITHOLOGIC LOG FROM TO LITHOLOGIC LOG									
0 15 Sandy Clay									
15 62 Sand and Gravel									
7 CONTRACTOR'S OR LANDOWNER'S CERTIFICATION: This water well was (1) constructed, (2) reconstructed, or (3) plugged under my jurisdiction and was completed on (mo/day/year) 12/3/82 and this record is true to the best of my knowledge and belief. Kansas Water Well Contractor's License No. 186 This Water Well Record was completed on (mo/day/yr) 1/11/83 under the business name of Kellys Water Well Service by (signature) [Signature]									
INSTRUCTIONS: Use typewriter or ball point pen, PLEASE PRESS FIRMLY and PRINT clearly. Please fill in blanks, underline or circle the correct answers. Send top three copies to Kansas Department of Health and Environment, Division of Environment, Environmental Geology Section, Topeka, KS 66620. Send one to WATER WELL OWNER and retain one for your records.									