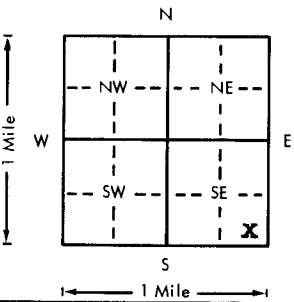


USE TYPEWRITER OR BALL  
POINT PEN-PRESS FIRMLY,  
PRINT CLEARLY.

WATER WELL RECORD  
KSA 82a-1201-1215

Kansas Department of Health and  
Environment-Division of Environment  
(Water well Contractors)  
Topeka, Kansas 66620

1. Location of well:		County <b>Pawnee</b>	Fraction <b>SE 1/4 SE 1/4 SE 1/4</b>	Section number <b>35</b>	Township number <b>T 22 S R 15 E/W</b>
2. Distance and direction from nearest town or city: <b>5 S. 2 W. from K-19 and Radium Rd.</b> Street address of well location if in city:			3. Owner of well: <b>M.K. Ashworth</b> Rt. 2 City, state, zip code: <b>Larned, Ks. 67550</b>		
4. Locate with "X" in section below: 			6. Bore hole dia. <b>11</b> in. Completion date <b>8-27-79</b> Well depth <b>84</b> ft.		
5. Type and color of material			7. <input type="checkbox"/> Cable tool <input checked="" type="checkbox"/> Rotary <input type="checkbox"/> Driven <input type="checkbox"/> Dug <input type="checkbox"/> Hollow rod <input type="checkbox"/> Jetted <input type="checkbox"/> Bored <input type="checkbox"/> Reverse rotary		
			8. Use: <input checked="" type="checkbox"/> Domestic <input type="checkbox"/> Public supply <input type="checkbox"/> Industry <input type="checkbox"/> Irrigation <input type="checkbox"/> Air conditioning <input type="checkbox"/> Stock <input type="checkbox"/> Lawn <input type="checkbox"/> Oil field water <input type="checkbox"/> Other		
			9. Casing: Material <b>PVC</b> Height: Above or below Threaded <input type="checkbox"/> Welded <input type="checkbox"/> Surface <b>12</b> in. RMP <b>5 1/2</b> PVC <b>84</b> Weight <input type="checkbox"/> lbs./ft. Dia. <b>1 1/2</b> in. to <b>84</b> ft. depth Wall Thickness: inches or Dia. <input type="checkbox"/> in. to <input type="checkbox"/> ft. depth Gauge No. <b>.258</b>		
			10. Screen: Manufacturer's name <b>certain teed</b> Type <b>PVC</b> Dia. <b>5 1/2</b> Slot/gauge <b>1/16</b> Length <b>20</b> Set between <b>84</b> ft. and <b>64</b> ft. Gravel pack? <input checked="" type="checkbox"/> Size range of material <b>3/4-3/8-1/2</b>		
			11. Static water level: <b>37</b> ft. below land surface Date <b>8-27-79</b> 12. Pumping level below land surfaces: <b>NA</b> ____ ft. after ____ hrs. pumping ____ g.p.m. ____ ft. after ____ hrs. pumping ____ g.p.m. Estimated maximum yield ____ g.p.m.		
13. Water sample submitted: <b>X</b> Yes <input type="checkbox"/> No Date <b>8-27-79</b>			14. Well head completion: <b>X</b> Pitless adapter <b>12</b> inches above grade		
15. Well grouted? <b>X</b> With: <b>X</b> Neat cement <input type="checkbox"/> Bentonite <input type="checkbox"/> Concrete Depth: From <b>0</b> ft. to <b>15</b> ft.			16. Nearest source of possible contamination: <b>60</b> ft. Direction <b>South</b> Type <b>septic tank</b> Well disinfected upon completion? <b>HTH</b> Yes <input type="checkbox"/> No		
17. Pump: <b>X</b> Not installed Manufacturer's name _____ Model number _____ HP _____ Volts _____ Length of drop pipe _____ ft. capacity _____ g.p.m. Type: _____ <input type="checkbox"/> Submersible <input type="checkbox"/> Turbine <input type="checkbox"/> Jet <input type="checkbox"/> Reciprocating <input type="checkbox"/> Centrifugal <input type="checkbox"/> Other			20. Water well contractor's certification: This well was drilled under my jurisdiction and this report is true to the best of my knowledge and belief. <b>Rosencrantz-Bemis 134</b> Business name <b>EX 713 Great Bend, Ks</b> License No. _____ Address _____ Signed <b>Fredia Dodson</b> Date <b>8-30-79</b> Authorized representative		
18. Elevation: Topography: <input type="checkbox"/> Hill <input type="checkbox"/> Slope <input type="checkbox"/> Upland <input checked="" type="checkbox"/> Valley			19. Remarks:  (Use a second sheet if needed)		

Forward the white, blue and pink copies to the Department of Health and Environment

Form WWC-5