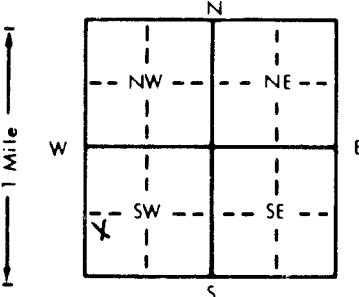


1 LOCATION OF WATER WELL: County: Pawnee		Fraction NW 1/4 MM SW 1/4 SW 1/4	Section Number 2	Township Number T 22 S	Range Number R 15 E
Distance and direction from nearest town or city street address of well if located within city? 3/4 south 7 1/2 east of Larned, Ks.					
2 WATER WELL OWNER: Albert Crane RR#, St. Address, Box #: Rt. 2-Box 99 City, State, ZIP Code: Larned, Ks. 67550 was 173 Board of Agriculture, Division of Water Resources Application Number:					
3 LOCATE WELL'S LOCATION WITH AN "X" IN SECTION BOX:		4 DEPTH OF COMPLETED WELL: 173 ft. ELEVATION:			
		Depth(s) Groundwater Encountered 1. ft. 2. ft. 3. ft.			
		WELL'S STATIC WATER LEVEL was 45 ft. below land surface measured on mo/day/yr 7-28-94			
		Pump test data: Well water was ft. after hours pumping gpm			
		Est. Yield gpm: Well water was ft. after hours pumping gpm			
Bore Hole Diameter in. to ft. and in. to ft.		WELL WATER TO BE USED AS:			
1 Domestic		3 Feedlot	6 Oil field water supply	9 Dewatering	12 Other (Specify below)
2 <u>Irrigation</u>		4 Industrial	7 Lawn and garden only	10 Monitoring well	
Was a chemical/bacteriological sample submitted to Department? Yes No If yes, mo/day/yr sample was submitted					
Water Well Disinfected? Yes HTH No					
5 TYPE OF BLANK CASING USED:					
1 Steel		3 RMP (SR)	6 Asbestos-Cement	9 Other (specify below)	
2 PVC		4 ABS	7 Fiberglass		
Blank casing diameter 16 in. to ft., Dia in. to ft., Dia in. to ft.					
Casing height above land surface 3' below in., weight lbs./ft. Wall thickness or gauge No.					
TYPE OF SCREEN OR PERFORATION MATERIAL:					
1 Steel		3 Stainless steel	5 Fiberglass	8 RMP (SR)	11 Other (specify) NA
2 Brass		4 Galvanized steel	6 Concrete tile	9 ABS	12 None used (open hole)
SCREEN OR PERFORATION OPENINGS ARE:					
1 Continuous slot		3 Mill slot	6 Wire wrapped	9 Drilled holes	
2 Louvered shutter		4 Key punched	7 Torch cut	10 Other (specify) NA	
SCREEN-PERFORATED INTERVALS: From NA ft. to NA ft., From ft. to ft.					
GRAVEL PACK INTERVALS: From ft. to ft., From ft. to ft.					
6 GROUT MATERIAL:					
1 Neat cement		2 <u>Cement grout</u>	3 Bentonite	4 Other	
Grout Intervals: From 45 ft. to 3 ft., From ft. to ft.					
What is the nearest source of possible contamination:					
1 Septic tank		4 Lateral lines	7 Pit privy	10 Livestock pens	14 Abandoned water well
2 Sewer lines		5 Cess pool	8 Sewage lagoon	11 Fuel storage	15 Oil well/Gas well
3 Watertight sewer lines		6 Seepage pit	9 Feedyard	12 Fertilizer storage	16 Other (specify below)
13 Insecticide storage					
Direction from well? How many feet?					
FROM	TO	LITHOLOGIC LOG	FROM	TO	PLUGGING INTERVALS
173	125	Sand and gravel			
125	123	Hole plug			
123	45	Sand			
45	3	Cement			
7 CONTRACTOR'S OR LANDOWNER'S CERTIFICATION: This water well was (1) constructed, (2) reconstructed, or (3) <u>plugged</u> under my jurisdiction and was completed on (mo/day/year) 8-11-94 and this record is true to the best of my knowledge and belief. Kansas Water Well Contractor's License No. 134 This Water Well Record was completed on (mo/day/yr) 8-14-94 under the business name of Rosencrantz-Bemis by (signature) <i>Indira Radwan</i>					
INSTRUCTIONS: Use typewriter or ball point pen. PLEASE PRESS FIRMLY and PRINT clearly. Please fill in blanks, underline or circle the correct answers. Send top three copies to Kansas Department of Health and Environment, Bureau of Water, Topeka, Kansas 66620-0001. Telephone: 913-296-5545. Send one to WATER WELL OWNER and retain one for your records.					