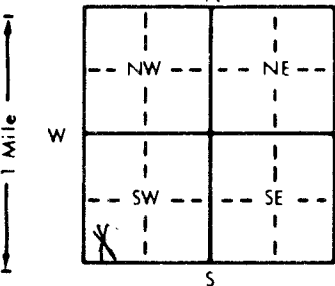


1 LOCATION OF WATER WELL:		Fraction	Section Number	Township Number	Range Number
County: <u>Pawnee</u>		<u>SW</u> $\frac{1}{4}$ <u>SW</u> $\frac{1}{4}$ <u>SW</u> $\frac{1}{4}$	<u>17</u>	<u>T</u> <u>22</u> <u>S</u>	<u>R</u> <u>15</u> <u>EW</u>
Distance and direction from nearest town or city street address of well if located within city? <u>5 east, 2 3/4 south of Larned, Ks.</u>					
2 WATER WELL OWNER:					
RR#, St. Address, Box # : <u>A.W. Scharitz Jr.</u>					
City, State, ZIP Code : <u>616 West 4th</u>					
<u>Larned, Ks. 67550</u>					
Board of Agriculture, Division of Water Resources					
Application Number:					
3 LOCATE WELL'S LOCATION WITH AN "X" IN SECTION BOX:		4 DEPTH OF COMPLETED WELL: <u>75</u> ft. ELEVATION:			
		Depth(s) Groundwater Encountered 1. ft. 2. ft. 3. ft.			
		WELL'S STATIC WATER LEVEL <u>36</u> ft. below land surface measured on mo/day/yr <u>9-29-94</u>			
		Pump test data: Well water was ft. after hours pumping gpm			
		Est. Yield <u>na</u> gpm: Well water was ft. after hours pumping gpm			
		Bore Hole Diameter <u>10</u> in. to <u>75</u> ft., and in. to ft.			
		WELL WATER TO BE USED AS:			
		5 Public water supply 8 Air conditioning 11 Injection well			
		1 Domestic 3 Feedlot 6 Oil field water supply 9 Dewatering 12 Other (Specify below)			
		2 Irrigation 4 Industrial 7 Lawn and garden only 10 Monitoring well <u>live stock</u>			
		Was a chemical/bacteriological sample submitted to Department? Yes.....No... <u>X</u>; If yes, mo/day/yr sample was submitted			
		Water Well Disinfected? Yes <u>hth</u> No			
5 TYPE OF BLANK CASING USED:					
1 Steel 3 RMP (SR) 5 Wrought iron 8 Concrete tile CASING JOINTS: Glued <u>X</u> Clamped					
2 PVC 4 ABS 6 Asbestos-Cement 9 Other (specify below) Welded					
3 Fiberglass Threaded					
Blank casing diameter <u>5</u> in. to <u>65</u> ft., Dia in. to ft., Dia in. to ft.					
Casing height above land surface <u>2</u> in., weight <u>258</u> lbs./ft. Wall thickness or gauge No.					
TYPE OF SCREEN OR PERFORATION MATERIAL:					
1 Steel 3 Stainless steel 5 Fiberglass 8 RMP (SR) 10 Asbestos-cement					
2 Brass 4 Galvanized steel 6 Concrete tile 9 ABS 11 Other (specify)					
12 None used (open hole)					
SCREEN OR PERFORATION OPENINGS ARE:					
1 Continuous slot 5 Gauzed wrapped 8 Saw cut 11 None (open hole)					
2 Louvered shutter 3 Mill slot 6 Wire wrapped 9 Drilled holes					
4 Key punched 7 Torch cut 10 Other (specify)					
SCREEN-PERFORATED INTERVALS: From <u>65</u> ft. to <u>75</u> ft., From ft. to ft.					
From ft. to ft., From ft. to ft.					
GRAVEL PACK INTERVALS: From <u>20</u> ft. to <u>75</u> ft., From ft. to ft.					
From ft. to ft., From ft. to ft.					
6 GROUT MATERIAL:					
1 Neat cement 2 Cement grout 3 Bentonite 4 Other <u>hole plug</u>					
Grout Intervals: From <u>0</u> ft. to <u>20</u> ft., From ft. to ft., From ft. to ft.					
What is the nearest source of possible contamination:					
1 Septic tank 4 Lateral lines 7 Pit privy 10 <u>Livestock pens</u> 14 Abandoned water well					
2 Sewer lines 5 Cess pool 8 Sewage lagoon 11 Fuel storage 15 Oil well/Gas well					
3 Watertight sewer lines 6 Seepage pit 9 Feedyard 12 Fertilizer storage 16 Other (specify below)					
13 Insecticide storage					
Direction from well? <u>south</u> How many feet? <u>1/2 mile</u>					
FROM	TO	LITHOLOGIC LOG	FROM	TO	PLUGGING INTERVALS
0	3	Top soil			
3	25	Brown & gray clay			
25	41	Fine to medium dark colored sand and gravel			
41	57	Orange, brown sandy clay			
57	75	Sand and gravel clean, coarse, loose			
7 CONTRACTOR'S OR LANDOWNER'S CERTIFICATION: This water well was (1) constructed, (2) reconstructed, or (3) plugged under my jurisdiction and was completed on (mo/day/year) <u>9-29-94</u> and this record is true to the best of my knowledge and belief. Kansas Water Well Contractor's License No. <u>134</u> This Water Well Record was completed on (mo/day/yr) <u>10-6-94</u>					
under the business name of <u>Rosencrantz-Bemis</u> by (signature) <u>Fredie Rodson</u>					
INSTRUCTIONS: Use typewriter or ball point pen. PLEASE PRESS FIRMLY and PRINT clearly. Please fill in blanks, underline or circle the correct answers. Send top three copies to Kansas Department of Health and Environment, Bureau of Water, Topeka, Kansas 66620-0001. Telephone: 913-296-5545. Send one to WATER WELL OWNER and retain one for your records.					