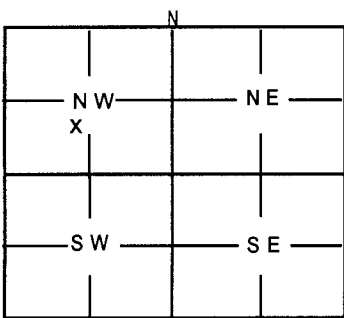
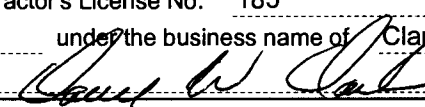


1	LOCATION OF WATER WELL:	Fraction	Section	Number	Township	Number	Range	Number																								
	County: <b>Pawnee</b>	<b>NE 1/4 SW 1/4 NW 1/4</b>	<b>6</b>		<b>T</b>	<b>22</b>	<b>S</b>	<b>R 16 E</b>																								
Distance and direction from nearest town or city street address of well if located within city? <b>Approximately 3/4 mile west and 1/4 mile south of Larned</b>																																
2	WATER WELL OWNER: <b>Jean B. Martin Revocable Trust</b> c/o Jean Martin, Trustee RR#, St. Address, Box # <b>Route 2 - Box 167B</b> City, State, ZIP Code <b>Oberlin, KS 67749</b> Board of Agriculture, Division of Water Resources Application Number: <b>VR PN50</b>																															
3	MARK WELL'S LOCATION WITH AN "X" IN SECTION BOX: <div style="text-align: center;">  </div>		4	DEPTH OF WELL <b>54</b> ft. WELL'S STATIC WATER LEVEL <b>19</b> ft. WELL WAS USED AS: <table style="width:100%;"> <tr> <td>1 Domestic</td> <td>5 Public Water Supply</td> <td>9 Dewatering</td> </tr> <tr> <td><b>2 Irrigation</b></td> <td>6 Oil Field Water Supply</td> <td>10 Monitoring Well</td> </tr> <tr> <td>3 Feedlot</td> <td>7 Domestic (Lawn &amp; Garden)</td> <td>11 Injection Well</td> </tr> <tr> <td>4 Industrial</td> <td>8 Air Conditioning</td> <td>12 Other</td> </tr> </table> Was a chemical / bacteriological sample submitted to Department? Yes _____ No <input checked="" type="checkbox"/> If yes, mo/day/yr sample was submitted _____ Water Well Disinfected: Yes <input checked="" type="checkbox"/> No _____					1 Domestic	5 Public Water Supply	9 Dewatering	<b>2 Irrigation</b>	6 Oil Field Water Supply	10 Monitoring Well	3 Feedlot	7 Domestic (Lawn & Garden)	11 Injection Well	4 Industrial	8 Air Conditioning	12 Other												
1 Domestic	5 Public Water Supply	9 Dewatering																														
<b>2 Irrigation</b>	6 Oil Field Water Supply	10 Monitoring Well																														
3 Feedlot	7 Domestic (Lawn & Garden)	11 Injection Well																														
4 Industrial	8 Air Conditioning	12 Other																														
5	TYPE OF BLANK CASING USED: <table style="width:100%;"> <tr> <td><b>1 Steel</b></td> <td>3 RMP (SR)</td> <td>5 Wrought</td> <td>7 Fiberglass</td> <td>9 Other (Specify below)</td> </tr> <tr> <td>2 PVC</td> <td>4 ABS</td> <td>6 Asbestos-Cement</td> <td>8 Concrete Tile</td> <td></td> </tr> </table> Blank casing diameter <b>16</b> in. Was casing pulled? Yes _____ No <input checked="" type="checkbox"/> Casing height above or <b>below</b> land surface <b>48</b> in. If yes, how much Cut off _____								<b>1 Steel</b>	3 RMP (SR)	5 Wrought	7 Fiberglass	9 Other (Specify below)	2 PVC	4 ABS	6 Asbestos-Cement	8 Concrete Tile															
<b>1 Steel</b>	3 RMP (SR)	5 Wrought	7 Fiberglass	9 Other (Specify below)																												
2 PVC	4 ABS	6 Asbestos-Cement	8 Concrete Tile																													
6	GROUT PLUG MATERIAL: 1 Neat Cement <b>2 Cement grout</b> 3 Bentonite 4 Other _____ Grout Plug Intervals: From <b>22</b> ft. to <b>4</b> ft., From _____ ft. to _____ ft. From _____ ft. to _____ ft. What is the nearest source of possible contamination: <table style="width:100%;"> <tr> <td>1 Septic tank</td> <td>6 Seepage pit</td> <td>11 Fuel storage</td> <td>16 Other (specify below)</td> </tr> <tr> <td>2 Sewer lines</td> <td>7 Pit privy</td> <td>12 Fertilizer storage</td> <td></td> </tr> <tr> <td>3 Watertight sewer lines</td> <td>8 Sewage lagoon</td> <td>13 Insecticide storage</td> <td><b>None known</b></td> </tr> <tr> <td>4 Lateral lines</td> <td>9 Feedyard</td> <td>14 Abandoned water well</td> <td></td> </tr> <tr> <td>5 Cess Pool</td> <td>10 Livestock pens</td> <td>15 Oil well/Gas well</td> <td></td> </tr> </table> Direction from well? _____ How many feet? _____								1 Septic tank	6 Seepage pit	11 Fuel storage	16 Other (specify below)	2 Sewer lines	7 Pit privy	12 Fertilizer storage		3 Watertight sewer lines	8 Sewage lagoon	13 Insecticide storage	<b>None known</b>	4 Lateral lines	9 Feedyard	14 Abandoned water well		5 Cess Pool	10 Livestock pens	15 Oil well/Gas well					
1 Septic tank	6 Seepage pit	11 Fuel storage	16 Other (specify below)																													
2 Sewer lines	7 Pit privy	12 Fertilizer storage																														
3 Watertight sewer lines	8 Sewage lagoon	13 Insecticide storage	<b>None known</b>																													
4 Lateral lines	9 Feedyard	14 Abandoned water well																														
5 Cess Pool	10 Livestock pens	15 Oil well/Gas well																														
<table border="1" style="width:100%; border-collapse: collapse;"> <thead> <tr> <th style="width:10%;">FROM</th> <th style="width:10%;">TO</th> <th style="width:80%;">PLUGGING MATERIALS</th> </tr> </thead> <tbody> <tr> <td style="text-align: center;">54</td> <td style="text-align: center;">22</td> <td>Chlorinated Sand</td> </tr> <tr> <td style="text-align: center;">22</td> <td style="text-align: center;">4</td> <td>Concrete Grout</td> </tr> <tr> <td style="text-align: center;">4</td> <td style="text-align: center;">0</td> <td>Compacted Soil</td> </tr> <tr><td> </td><td> </td><td> </td></tr> <tr><td> </td><td> </td><td> </td></tr> <tr><td> </td><td> </td><td> </td></tr> <tr><td> </td><td> </td><td> </td></tr> </tbody> </table>									FROM	TO	PLUGGING MATERIALS	54	22	Chlorinated Sand	22	4	Concrete Grout	4	0	Compacted Soil												
FROM	TO	PLUGGING MATERIALS																														
54	22	Chlorinated Sand																														
22	4	Concrete Grout																														
4	0	Compacted Soil																														
7	CONTRACTOR'S OR LANDOWNER'S CERTIFICATION: This water well was plugged under my jurisdiction and was completed on (mo/day/year) <b>4-30-02</b> and this record is true to the best of my knowledge and belief. Kansas Water Well Contractor's License No. <b>185</b> This Water Well Record was completed on (mo/day/year) <b>5-15-02</b> under the business name of <b>Clarke Well &amp; Equipment, Inc.</b> by (signature) 																															
INSTRUCTIONS: Use typewriter or ball point pen. Please press firmly and print clearly. Please fill in blanks, underline or circle the correct answers. Send top three copies to Kansas Department of Health & Environment, Bureau of Water, Topeka, Kansas 66620-0001. Telephone: 785/296-3565. Send one to Water Well Owner and retain one for your records.																																