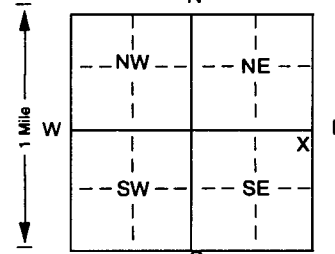


1 LOCATION OF WATER WELL:		Fraction		Section Number		Township Number		Range Number	
County: Pawnee		NE 1/4 NE 1/4 SE 1/4		8		T 22 S		R 16 E (W)	
Distance and direction from nearest town or city street address of well if located within city?									
Approximately 1 1/2 miles south of Larned									
2 WATER WELL OWNER: Kansas Department of Transportation									
RR#, St. Address, Box # : 500 N. Hendricks					Board of Agriculture, Division of Water Resources				
City, State, ZIP Code : Hutchinson, KS 67504					Application Number:				
3 LOCATE WELL'S LOCATION WITH AN "X" IN SECTION BOX:		4 DEPTH OF COMPLETED WELL 52 ft. ELEVATION: unknown							
		Depth(s) Groundwater Encountered 1 ft. 2 ft. 3 ft.							
		WELL'S STATIC WATER LEVEL 18.11 ft. below land surface measured on mo/day/yr 11-4-03							
		Pump test data: Well water was not checked ft. after hours pumping gpm							
		Est. Yield unknown gpm: Well water was ft. after hours pumping gpm							
		Bore Hole Diameter 9 in. to 52 ft., and in. to ft.							
WELL WATER TO BE USED AS: 5 Public water supply 8 Air conditioning 11 Injection well									
1 Domestic 3 Feedlot 6 Oil field water supply 9 Dewatering 12 Other (specify below)									
2 Irrigation 4 Industrial 7 Domestic (lawn & garden) 10 Monitoring well Water Supply Well									
Was a chemical/bacteriological sample submitted to Department? Yes No If yes, mo/day/yr sample was submitted									
Water Well Disinfected? Yes No									
5 TYPE OF BLANK CASING USED:									
1 Steel 3 RMP (SR) 5 Wrought iron 8 Concrete tile CASING JOINTS: Glued Clamped									
2 PVC 4 ABS 6 Asbestos-Cement 9 Other (specify below) Welded									
7 Fiberglass Threaded									
Blank casing diameter 5 in. to 38 ft., Dia in. to ft., Dia in. to ft.									
Casing height above land surface 24 in., weight 2.36 lbs./ft. Wall thickness or gauge No .214									
TYPE OF SCREEN OR PERFORATION MATERIAL:									
1 Steel 3 Stainless steel 5 Fiberglass 8 RMP (SR) 10 Asbestos-cement									
2 Brass 4 Galvanized steel 6 Concrete tile 9 ABS 11 Other (specify)									
12 None used (open hole)									
SCREEN OR PERFORATION OPENINGS ARE:									
1 Continuous slot 3 Mill slot 5 Gauzed wrapped 8 Saw cut 11 None (open hole)									
2 Louvered shutter 4 Key punched 6 Wire wrapped 9 Drilled holes									
3 Torch cut 10 Other (specify) ft.									
SCREEN-PERFORATED INTERVALS: From 38 ft. to 50 ft., From ft. to ft.									
GRAVEL PACK INTERVALS: From 24 ft. to 50 ft., From ft. to ft.									
6 GROUT MATERIAL: 1 Neat cement 2 Cement grout 3 Bentonite 4 Other Bentonite Holeplug									
Grout Intervals: From ft. to ft., From ft. to ft., From 0 ft. to 24 ft.									
What is the nearest source of possible contamination:									
1 Septic tank 4 Lateral lines 7 Pit privy 10 Livestock pens 14 Abandoned water well									
2 Sewer lines 5 Cess pool 8 Sewage lagoon 11 Fuel storage 15 Oil well/Gas well									
3 Watertight sewer lines 6 Seepage pit 9 Feedyard 12 Fertilizer storage 16 Other (specify below)									
None known									
Direction from well? How many feet?									
FROM TO LITHOLOGIC LOG FROM TO PLUGGING INTERVALS									
0 3 Topsoil									
3 10 Clay, tan									
10 50 Sand and gravel with thin clay streaks									
50 52 Dakota clay									
7 CONTRACTOR'S OR LANDOWNER'S CERTIFICATION: This water well was (1) constructed (2) reconstructed or (3) plugged under my jurisdiction and was completed on (mo/day/year) 11-4-03 and this record is true to the best of my knowledge and belief. Kansas Water Well Contractor's License No 185 This Water Well Record was completed on (mo/day/yr) 11-5-03 by (signature) Clarke Well & Equipment, Inc.									
INSTRUCTIONS: Use typewriter or ball point pen. PLEASE PRESS FIRMLY and PRINT clearly. Please fill in blanks, underline or circle the correct answers. Send top three copies to Kansas Department of Health and Environment, Bureau of Water, Topeka, Kansas 66620-0001. Telephone 785-296-5524. Send one to WATER WELL OWNER and retain one for your records. Fee of \$5.00 for each constructed well.									