

# WATER WELL PLUGGING RECORD Form WWC-5P KSA 82a-1212 ID NO.

1 LOCATION OF WATER WELL: County: Pawnee	Fraction 1/4 NW 1/4 NW 1/4 NE 1/4	Section Number 5	Township Number T 22 S	Range Number 16 <input type="checkbox"/> E <input checked="" type="checkbox"/> W
---	--------------------------------------	---------------------	---------------------------	---

Street/Rural Address of Well Location; if unknown, distance & direction from nearest town or intersection: If at owner's address, check here ☐

444 SW Trail (Hwy 56), Larned

## Global Positioning Systems (GPS) information:

Latitude: \_\_\_\_\_ (in decimal degrees)

Longitude: \_\_\_\_\_ (in decimal degrees)

Elevation: \_\_\_\_\_

Datum: ☐ WGS84, ☐ NAD83, ☐ NAD27

## Collection Method:


☐ GPS unit (Make/Model: \_\_\_\_\_)

☐ Digital Map/Photo, ☐ Topographic Map, ☐ Land Survey

Est. Accuracy: ☐ < 3 m, ☐ 3-5 m, ☐ 5-15 m, ☐ > 15 m

2 WATER WELL OWNER: KDHE  
RR#, St. Address, Box #: 1000 SW Jackson, Ste 410  
City, State ZIP Code: Topeka, KS 66612-1367

## 3 MARK WELL'S LOCATION WITH AN "X" IN SECTION BOX:

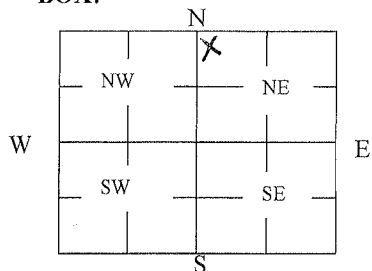

4 DEPTH OF WELL 25.15 ft.

WELL'S STATIC WATER LEVEL 18.77 ft

WELL WAS USED AS:

☐ Domestic  
☐ Irrigation  
☐ Feedlot  
☐ Industrial

☐ Public Water Supply  
☐ Oil Field Water Supply  
☐ Domestic (Lawn & Garden)  
☐ Air Conditioning

☐ Dewatering  
☒ Monitoring  
☐ Injection Well  
☐ Other \_\_\_\_\_

Was a chemical/bacteriological sample submitted to Department? Yes ☐ No ☒

## 5 TYPE OF BLANK CASING USED:

☐ Steel ☐ RMP (SR) ☐ Wrought ☐ Fiberglass ☐ Other (Specify below)  
☒ PVC ☐ ABS ☐ Asbestos-Cement ☐ Concrete Tile

Blank casing diameter 2 in. Was casing pulled? Yes ☒ No ☐ If yes, how much 3'  
Casing height above or below land surface ~24 in.

6 GROUT PLUG MATERIAL: ☐ Neat cement ☐ Cement grout ☒ Bentonite ☐ Other \_\_\_\_\_

Grout Plug Intervals: From 3 ft. to 25.15 ft., From \_\_\_\_\_ ft. to \_\_\_\_\_ ft., From \_\_\_\_\_ to \_\_\_\_\_ ft.

What is the nearest source of possible contamination:

☐ Septic tank ☐ Seepage pit ☐ Fuel Storage ☐ Other (specify below)  
☐ Sewer lines ☐ Pit privy ☐ Fertilizer storage  
☐ Watertight sewer lines ☐ Sewage lagoon ☐ Insecticide storage  
☐ Lateral lines ☐ Feedyard ☐ Abandoned water well  
☐ Cess pool ☐ Livestock pens ☐ Oil well/Gas well

Direction from well? \_\_\_\_\_  
How many feet? \_\_\_\_\_

FROM	TO	PLUGGING MATERIALS	FROM	TO	PLUGGING MATERIALS
0	3	Native soil			
3	25.15	Bentonite			
					MW1

7 CONTRACTOR'S OR LANDOWNER'S CERTIFICATION: This water well was plugged under my jurisdiction and was completed on (mo/day/year) 6/13/2011 and this record is true to the best of my knowledge and belief. Kansas Water Well Contractor's License No. 527. This Water Well Record was completed on (mo/day/year) 6/14/2011 under the business name of GeoCore Inc. by (signature) *Joe Loh*

INSTRUCTIONS: Use typewriter or ballpoint pen. Please press firmly and print clearly. Please fill in blanks, underline or circle the correct answers. Send top three copies to Kansas Department of Health and Environment, Bureau of Water, Geology Section, 1000 SW Jackson St., Ste. 420, Topeka, Kansas 66612-1367. Telephone: 785/296-5524. Send one to Water Well Owner and retain one for your records. Visit us at <http://www.kdheks.gov/waterwell/index.html>.

Check one: ☐ White Copy ☐ Blue Copy ☐ Pink Copy