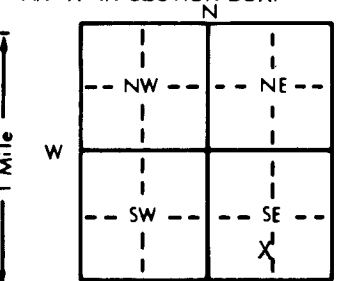


1 LOCATION OF WATER WELL:		Fraction	Section Number	Township Number	Range Number
County: PAWNEE		SE 1/4 SW 1/4 SE 1/4	1	T 22 S	R 16 E/W
Distance and direction from nearest town or city street address of well if located within city? 1-S 3 1/2 E. OF LARNED,KS.					
2 WATER WELL OWNER: WOODMAN-IANNITTI DRILLING					
RR#, St. Address, Box # : P.O.BOX 308			Board of Agriculture, Division of Water Resources		
City, State, ZIP Code GREAT BEND,KS. 67530			Application Number: 92-0294		
3 LOCATE WELL'S LOCATION WITH AN "X" IN SECTION BOX:		4 DEPTH OF COMPLETED WELL: 70 ft. ELEVATION:			
		Depth(s) Groundwater Encountered 1. ft. 2. ft. 3. ft. WELL'S STATIC WATER LEVEL 24 ft. below land surface measured on mo/day/yr Pump test data: Well water was ft. after hours pumping gpm Est. Yield gpm: Well water was ft. after hours pumping gpm Bore Hole Diameter 9 in. to ft., and in. to ft. WELL WATER TO BE USED AS: 5 Public water supply 8 Air conditioning 11 Injection well 1 Domestic 3 Feedlot XX Oil field water supply 9 Dewatering 12 Other (Specify below) 2 Irrigation 4 Industrial 7 Lawn and garden only 10 Monitoring well Was a chemical/bacteriological sample submitted to Department? Yes No X; If yes, mo/day/yr sample was submitted Water Well Disinfected? Yes No X			
5 TYPE OF BLANK CASING USED:					
1 Steel 3 RMP (SR) 5 Wrought iron 8 Concrete tile CASING JOINTS: Glued X Clamped					
XX 2 PVC 4 ABS 6 Asbestos-Cement 9 Other (specify below) Welded					
Blank casing diameter 5 in. to 60 ft., Dia in. to ft., Dia in. to ft.					
Casing height above land surface 18 in., weight lbs./ft. Wall thickness or gauge No.					
TYPE OF SCREEN OR PERFORATION MATERIAL: XX 7 PVC 10 Asbestos-cement					
1 Steel 3 Stainless steel 5 Fiberglass 8 RMP (SR) 11 Other (specify)					
2 Brass 4 Galvanized steel 6 Concrete tile 9 ABS 12 None used (open hole)					
SCREEN OR PERFORATION OPENINGS ARE:					
1 Continuous slot XX Mill slot 5 Gauzed wrapped 8 Saw cut 11 None (open hole)					
2 Louvered shutter 4 Key punched 6 Wire wrapped 9 Drilled holes					
3 Torch cut 10 Other (specify)					
SCREEN-PERFORATED INTERVALS: From 60 ft. to 70 ft., From ft. to ft.					
GRAVEL PACK INTERVALS: From 20 ft. to 70 ft., From ft. to ft.					
6 GROUT MATERIAL: 1 Neat cement 2 Cement grout XX 3 Bentonite 4 Other					
Grout Intervals: From 0 ft. to 20 ft., From ft. to ft., From ft. to ft.					
What is the nearest source of possible contamination:					
1 Septic tank 4 Lateral lines 7 Pit privy 10 Livestock pens 14 Abandoned water well					
2 Sewer lines 5 Cess pool 8 Sewage lagoon 11 Fuel storage 15 Oil well/Gas well					
3 Watertight sewer lines 6 Seepage pit 9 Feedyard 12 Fertilizer storage 16 Other (specify below)					
13 Insecticide storage NONE					
Direction from well? How many feet?					
FROM TO LITHOLOGIC LOG FROM TO PLUGGING INTERVALS					
0 3 TOP SOIL					
3 40 CLAY					
40 70 GRAVEL					
7 CONTRACTOR'S OR LANDOWNER'S CERTIFICATION: This water well was (XX) constructed, (2) reconstructed, or (3) plugged under my jurisdiction and was completed on (mo/day/year) 8-28-92 and this record is true to the best of my knowledge and belief. Kansas Water Well Contractor's License No. 462-8 This Water Well Record was completed on (mo/day/yr) 10-10-92 under the business name of SAM'S WATER WELL SERVICE by (signature) [Signature]					
INSTRUCTIONS: Use typewriter or ball point pen. PLEASE PRESS FIRMLY and PRINT clearly. Please fill in blanks, underline or circle the correct answers. Send top three copies to Kansas Department of Health and Environment, Bureau of Water, Topeka, Kansas 66620-0001. Telephone: 913-296-5545. Send one to WATER WELL OWNER and retain one for your records.					