


1 LOCATION OF WATER WELL:	Fraction	Section Number	Township Number	Range Number
County: <u>Dawson</u>	NW ¼ SE ¼ SE ¼	2	T 22 S	R 16 SW

Distance and direction from nearest town or city street address of well if located within city?
2 miles east, 1 1/8 south of Larned, Ks.

2	WATER WELL OWNER:	Lester Davis	Leonard Wurm Est.	
	RR#, St. Address, Box # :	1103 College		Board of Agriculture, Division of Water Resources
	City, State, ZIP Code :	Larned, Ks.	67550	Application Number: 32,538

3] LOCATE WELL'S LOCATION WITH AN "X" IN SECTION BOX: 4] DEPTH OF COMPLETED WELL..... 56 ft. ELEVATION:
Depth(s) Groundwater Encountered 1..... ft. 2..... ft. 3..... ft.

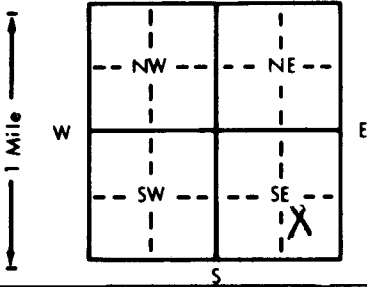

4 DEPTH OF COMPLETED WELL..... 56 ft. ELEVATION:
 Depth(s) Groundwater Encountered 1. ft. 2. ft. 3. ft.
 WELL'S STATIC WATER LEVEL 26½ ft. below land surface measured on mo/day/yr 1-29-92
 Pump test data: Well water was ~~xxx~~ 44 ft. after 1 hours pumping 350 gpm
 Est. Yield gpm: Well water was ft. after hours pumping gpm
 Bore Hole Diameter..... 26 in. to 56 ft., and in. to ft.
 WELL WATER TO BE USED AS:
 1 Domestic 3 Feedlot 6 Oil field water supply 8 Air conditioning 11 Injection well
 2 Irrigation 4 Industrial 7 Lawn and garden only 10 Dewatering 12 Other (Specify below)
 2 Irrigation 4 Industrial 7 Lawn and garden only 10 Monitoring well
 Was a chemical/bacteriological sample submitted to Department? Yes.....No...X.....; If yes, mo/day/yr sample was sub-
 mitted Water Well Disinfected? Yes hth No

5	TYPE OF BLANK CASING USED:		5 Wrought iron	8 Concrete tile	CASING JOINTS: Glued .X. .Clamped Welded Threaded
	1 Steel	3 RMP (SR)	6 Asbestos-Cement	9 Other (specify below)	
	2 <u>PVC</u>	4 ABS	7 Fiberglass		

Blank casing diameter 16 . . . in. to 36 . . . ft., Dia in. to ft., Dia in. to ft.
Casing height above land surface 12 . . . in., weight SDR 32.5 lbs./ft. Wall thickness or gauge No.

TYPE OF SCREEN OR PERFORATION MATERIAL:			<u>7 PVC</u>	10 Asbestos-cement
1 Steel	3 Stainless steel	5 Fiberglass	8 RMP (SR)	11 Other (specify)
2 Brass	4 Galvanized steel	6 Concrete tile	9 ABS	12 None used (open hole)

SCREEN OR PERFORATION OPENINGS ARE:

1 Continuous slot	3 <u>Mill slot</u>	5 Gauzed wrapped	8 Saw cut	11 None (open hole)
2 Louvered shutter	4 Key punched	6 Wire wrapped	9 Drilled holes	
		7 Torch cut	10 Other (specify)	

SCREEN-PERFORATED INTERVALS:	From 36	ft. to 56	ft., From	ft. to	ft.
	From	ft. to	ft., From	ft. to	ft.
GRAVEL PACK INTERVALS:	From 20	ft. to 56	ft., From	ft. to	ft.
	From	ft. to	ft., From	ft. to	ft.

6 GROUT MATERIAL: 1 Neat cement 2 Cement grout 3 Bentonite 4 Other

Grout Intervals: From 0 ft. to 20 ft., From ft. to ft., From ft. to ft.

What is the nearest source of possible contamination:

1 Septic tank	4 Lateral lines	7 Pit privy	10 Livestock pens	14 Abandoned water well
2 Sewer lines	5 Cess pool	8 Sewage lagoon	11 Fuel storage	15 Oil well/Gas well
3 Watertight sewer lines	6 Seepage pit	9 Feedyard	12 Fertilizer storage	16 Other (specify below)
			13 Insecticide storage	none

Direction from well?				How many feet?			
FROM	TO	LITHOLOGIC LOG		FROM	TO	PLUGGING INTERVAL	

[illegible]

7 CONTRACTOR'S OR LANDOWNER'S CERTIFICATION: This water well was (1) constructed, (2) reconstructed, or (3) plugged under my jurisdiction and was completed on (mo/day/year) 2-20-92 and this record is true to the best of my knowledge and belief. Kansas Water Well Contractor's License No. 134 This Water Well Record was completed on (mo/day/yr) 2-26-92 under the business name of Rosencrantz-Bemis by (signature) Tradin Roden