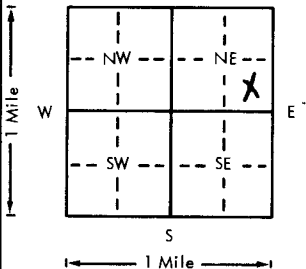


USE TYPEWRITER OR BALL
POINT PEN-PRESS FIRMLY,
PRINT CLEARLY.

WATER WELL RECORD
KSA 82a-1201-1215

Kansas Department of Health and
Environment-Division of Environment
(Water well Contractors)
Topeka, Kansas 66620

1. Location of well:		County PAWNEE	Fraction C 1/4 SE 1/4 NE 1/4	Section number 16	Township number T 22	Range number S R 16 E
2. Distance and direction from nearest town or city: 2.5 mi. 1/2 E of Larned, Ks. Street address of well location if in city:			3. Owner of well: Jerry Marmie R.R. or street: Rt 3 City, state, zip code: Great Bend, Ks 67530			
4. Locate with "X" in section below: 			Sketch map:		6. Bore hole dia. 3 3/4 in. Completion date Well depth 70 ft. 8-23-78	
5. Type and color of material			From	To	7. <input type="checkbox"/> Cable tool <input checked="" type="checkbox"/> Rotary <input type="checkbox"/> Driven <input type="checkbox"/> Dug <input type="checkbox"/> Hollow rod <input type="checkbox"/> Jetted <input type="checkbox"/> Bored <input type="checkbox"/> Reverse rotary	
Top soil			0	2	8. Use: <input type="checkbox"/> Domestic <input type="checkbox"/> Public supply <input type="checkbox"/> Industry <input checked="" type="checkbox"/> Irrigation <input type="checkbox"/> Air conditioning <input type="checkbox"/> Stock <input type="checkbox"/> Lawn <input type="checkbox"/> Oil field water <input type="checkbox"/> Other	
Clay			2	18	9. Casing: Material steel Height: Above or below Threaded <input type="checkbox"/> Welded <input type="checkbox"/> Surface 18 in. RMP <input type="checkbox"/> PVC <input type="checkbox"/> Weight <input type="checkbox"/> lbs./ft. Dia. 1 1/2 in. to 70 ft. depth Wall Thickness: inches or Dia. <input type="checkbox"/> in. to <input type="checkbox"/> ft. depth gage No. 7	
Sand & gravel			18	36	10. Screen: Manufacturer's name Oerrens Type steel Dia. 1 1/2 in. mts Slot 3/16 Length 24 Set between 70 ft. and 46 ft. Gravel pack? <input checked="" type="checkbox"/> Size range of material 1/2 to 3/4	
Clay			36	39	11. Static water level: <input type="checkbox"/> mo./day/yr. 32 ft. below land surface Date 7-5-78	
Sand & gravel			39	48	12. Pumping level below land surfaces: 50 ft. after 1 hrs. pumping 200 g.p.m. <input type="checkbox"/> ft. after <input type="checkbox"/> hrs. pumping <input type="checkbox"/> g.p.m. Estimated maximum yield 450 g.p.m.	
Clay			48	52	13. Water sample submitted: <input type="checkbox"/> Yes <input checked="" type="checkbox"/> No Date 7-5-78	
Sand & gravel			52	68	14. Well head completion: <input type="checkbox"/> Pitless adapter <input type="checkbox"/> Inches above grade	
Clay			68	75	15. Well grouted? <input checked="" type="checkbox"/> With: <input checked="" type="checkbox"/> Neat cement <input type="checkbox"/> Bentonite <input type="checkbox"/> Concrete Depth: From 0 ft. to 10 ft.	
					16. Nearest source of possible contamination: ft. 100 Direction N Type feed yard Well disinfected upon completion? <input checked="" type="checkbox"/> Yes <input type="checkbox"/> No	
					17. Pump: Manufacturer's name W.H.R. Not installed Model number 5-10CHC HP 30 Volts 460 Length of drop pipe 60 ft. capacity <input type="checkbox"/> g.p.m. Type: <input type="checkbox"/> Submersible <input checked="" type="checkbox"/> Turbine <input type="checkbox"/> Jet <input type="checkbox"/> Reciprocating <input type="checkbox"/> Centrifugal <input type="checkbox"/> Other	
18. Elevation:			20. Water well contractor's certification: This well was drilled under my jurisdiction and this report is true to the best of my knowledge and belief. Rosencrantz-Bemis 134 Business name License No. Address Great Bend, Ks. 67530 Signed Sandy Lilje Date 10-18-78 Authorized representative			
19. Remarks:						

Forward the white, blue and pink copies to the Department of Health and Environment

Form WWC-5