


|  |   |                             |                                  |                                 |
|--|---|-----------------------------|----------------------------------|---------------------------------|
| 1 LOCATION OF WATER WELL:<br>County: <b>Pawnee</b> | Fraction<br><b>NW <del>SW</del> 1/4 NW 1/4 SW 1/4</b> | Section Number<br><b>16</b> | Township Number<br><b>T 22 S</b> | Range Number<br><b>R 16W EW</b> |
|--|---|-----------------------------|----------------------------------|---------------------------------|

Distance and direction from nearest town or city street address of well if located within city?  
**2 1/2 S of Larned, Kansas 67550**

2 WATER WELL OWNER: **Bev Hungate**  
 RR#, St. Address, Box # : **Route 2**  
 City, State, ZIP Code : **Larned, Ks. 67550**

Board of Agriculture, Division of Water Resources  
Application Number:

3 LOCATE WELL'S LOCATION WITH AN "X" IN SECTION BOX: **4** DEPTH OF COMPLETED WELL **.59** ft. ELEVATION: **Unknown**

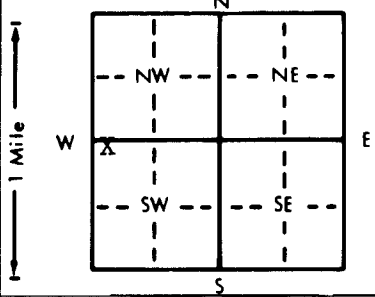

Depth(s) Groundwater Encountered **1.38** ft. **2.** ft. **3.** ft.

WELL'S STATIC WATER LEVEL **38** ft. below land surface measured on mo/day/yr **3/15/93**



Bore Hole Diameter **8** in. to **.59** ft., and **8** in. to **59** ft.

WELL WATER TO BE USED AS: **5** Public water supply **8** Air conditioning **11** Injection well  
**1** Domestic **3** Feedlot **6** Oil field water supply **9** Dewatering **12** Other (Specify below)  
**2** Irrigation **4** Industrial **7** Lawn and garden only **10** Monitoring well

Was a chemical/bacteriological sample submitted to Department? Yes.....No.....; If yes, mo/day/yr sample was submitted

Water Well Disinfected? Yes      No

5 TYPE OF BLANK CASING USED:

|         |            |                   |                         |  |
|---------|------------|-------------------|-------------------------|--|
| 1 Steel | 3 RMP (SR) | 5 Wrought iron    | 8 Concrete tile         | CASING JOINTS: <u>Glued</u> <u>Clamped</u> |
| 2 PVC   | 4 ABS      | 6 Asbestos-Cement | 9 Other (specify below) | <u>Welded</u>                              |
|         |            | 7 Fiberglass      |                         | <u>Threaded</u>                            |


Casing height above land surface **12** in., weight **8.8** lbs./ft. Wall thickness or gauge No. **Sch. 40**

TYPE OF SCREEN OR PERFORATION MATERIAL:

|         |                    |                 |            |                          |
|---------|--------------------|-----------------|------------|--------------------------|
| 1 Steel | 3 Stainless steel  | 5 Fiberglass    | 8 RMP (SR) | 10 Asbestos-cement       |
| 2 Brass | 4 Galvanized steel | 6 Concrete tile | 9 ABS      | 11 Other (specify)       |
|         |                    |                 |            | 12 None used (open hole) |

SCREEN OR PERFORATION OPENINGS ARE:

|                    |               |                  |                    |                     |
|--------------------|---------------|------------------|--------------------|---------------------|
| 1 Continuous slot  | 3 Mill slot   | 5 Gauzed wrapped | 8 <u>Saw cut</u>   | 11 None (open hole) |
| 2 Louvered shutter | 4 Key punched | 6 Wire wrapped   | 9 Drilled holes    |                     |
|                    |               | 7 Torch cut      | 10 Other (specify) |                     |



6 GROUT MATERIAL: **1** Neat cement **2** Cement grout **3** Bentonite **4** Other


What is the nearest source of possible contamination:

|                          |                 |                 |                        |                          |
|--------------------------|-----------------|-----------------|------------------------|--------------------------|
| 1 <u>Septic tank</u>     | 4 Lateral lines | 7 Pit privy     | 10 Livestock pens      | 14 Abandoned water well  |
| 2 Sewer lines            | 5 Cess pool     | 8 Sewage lagoon | 11 Fuel storage        | 15 Oil well/Gas well     |
| 3 Watertight sewer lines | 6 Seepage pit   | 9 Feedyard      | 12 Fertilizer storage  | 16 Other (specify below) |
|                          |                 |                 | 13 Insecticide storage |                          |

Direction from well? **East** How many feet? **150**

| FROM | TO | LITHOLOGIC LOG  | FROM | TO | PLUGGING INTERVALS |
|------|----|-----------------|------|----|--------------------|
| 0    | 35 | Clay            |      |    |                    |
| 35   | 59 | Sand and gravel |      |    |                    |
|      |    |                 |      |    |                    |
|      |    |                 |      |    |                    |
7 CONTRACTOR'S OR LANDOWNER'S CERTIFICATION: This water well was (1) constructed, (2) reconstructed, or (3) plugged under my jurisdiction and was completed on (mo/day/year) **3/15/93** and this record is true to the best of my knowledge and belief. Kansas Water Well Contractor's License No. **186** This Water Well Record was completed on (mo/day/yr) **4/14/93** under the business name of **Kelly's Water Well Service, Inc.** by (signature) *[Signature]*

INSTRUCTIONS: Use typewriter or ball point pen. PLEASE PRESS FIRMLY and PRINT clearly. Please fill in blanks, underline or circle the correct answers. Send top three copies to Kansas Department of Health and Environment, Bureau of Water, Topeka, Kansas 66620-0001. Telephone: 913-296-5545. Send one to WATER WELL OWNER and retain one for your records.

OFFICE USE ONLY  
T  
R  
EW  
SEC.  
1/4  
1/4  
1/4