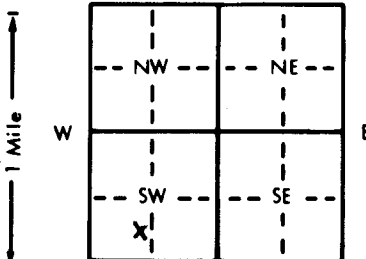


1 LOCATION OF WATER WELL:		Fraction	Section Number	Township Number	Range Number
County: Pawnee		C E 1/2 1/4 SW 1/4 SW 1/4	17	T 22 S	R 16 EW
Distance and direction from nearest town or city street address of well if located within city?					
2 3/4 south of Larned					
2 WATER WELL OWNER: Raymond Frick					
RR#, St. Address, Box # : Rt. 2					
City, State, ZIP Code : Larned, Ks. 67550					
Board of Agriculture, Division of Water Resources					
Application Number:					
3 LOCATE WELL'S LOCATION WITH AN "X" IN SECTION BOX:		4 DEPTH OF COMPLETED WELL 40 ft. ELEVATION:			
		Depth(s) Groundwater Encountered 1 8 ft. 2 ft. 3 ft.			
		WELL'S STATIC WATER LEVEL 12 ft. below land surface measured on mo/day/yr 1-27-82			
		Pump test data: Well water was ft. after hours pumping gpm			
		Est. Yield NA gpm: Well water was ft. after hours pumping gpm			
		Bore Hole Diameter 11 in. to 40 ft., and in. to ft.			
		WELL WATER TO BE USED AS: 5 Public water supply 8 Air conditioning 11 Injection well			
		1 Domestic 3 Feedlot 6 Oil field water supply 9 Dewatering 12 Other (Specify below)			
		2 Irrigation 4 Industrial 7 Lawn and garden only 10 Observation well Stock			
		Was a chemical/bacteriological sample submitted to Department? Yes No X; If yes, mo/day/yr sample was submitted			
		Water Well Disinfected? Yes HTH No			
5 TYPE OF BLANK CASING USED:					
1 Steel 3 RMP (SR) 5 Wrought iron 8 Concrete tile CASING JOINTS: Glued X Clamped					
2 PVC 4 ABS 6 Asbestos-Cement 9 Other (specify below) Welded					
3 Fiberglass Threaded					
Blank casing diameter 5 in. to 30 ft., Dia in. to ft., Dia in. to ft.					
Casing height above land surface 18 in., weight lbs./ft. Wall thickness or gauge No. 258					
TYPE OF SCREEN OR PERFORATION MATERIAL:					
1 Steel 3 Stainless steel 5 Fiberglass 8 RMP (SR) 10 Asbestos-cement					
2 Brass 4 Galvanized steel 6 Concrete tile 9 ABS 11 Other (specify)					
12 None used (open hole)					
SCREEN OR PERFORATION OPENINGS ARE:					
1 Continuous slot 3 Mill slot 5 Gauzed wrapped 8 Saw cut 11 None (open hole)					
2 Louvered shutter 4 Key punched 6 Wire wrapped 9 Drilled holes					
7 Torch cut 10 Other (specify)					
SCREEN-PERFORATED INTERVALS: From 30 ft. to 40 ft., From ft. to ft.					
GRAVEL PACK INTERVALS: From 10 ft. to 40 ft., From ft. to ft.					
6 GROUT MATERIAL: 1 Neat cement 2 Cement grout 3 Bentonite 4 Other					
Grout intervals: From 0 ft. to 10 ft., From ft. to ft., From ft. to ft.					
What is the nearest source of possible contamination:					
1 Septic tank 4 Lateral lines 7 Pit privy 10 Livestock pens 14 Abandoned water well					
2 Sewer lines 5 Cess pool 8 Sewage lagoon 11 Fuel storage 15 Oil well/Gas well					
3 Watertight sewer lines 6 Seepage pit 9 Feedyard 12 Fertilizer storage 16 Other (specify below)					
13 Insecticide storage					
Direction from well? West How many feet? 1000					
FROM TO LITHOLOGIC LOG FROM TO LITHOLOGIC LOG					
0 3 Sandy top soil					
3 11 Sandy brown clay and fine sand					
11 40 Sand and gravel					
7 CONTRACTOR'S OR LANDOWNER'S CERTIFICATION: This water well was (1) constructed, (2) reconstructed, or (3) plugged under my jurisdiction and was completed on (mo/day/year) 1-27-82 and this record is true to the best of my knowledge and belief. Kansas Water Well Contractor's License No. 134 This Water Well Record was completed on (mo/day/yr) 2-10-82 under the business name of Rosencrantz-Bemis Ent. by (signature) Lora Dodson					
INSTRUCTIONS: Use typewriter or ball point pen, PLEASE PRESS FIRMLY and PRINT clearly. Please fill in blanks, underline or circle the correct answers. Send top three copies to Kansas Department of Health and Environment, Division of Environment, Environmental Geology Section, Topeka, KS 66620. Send one to WATER WELL OWNER and retain one for your records.					