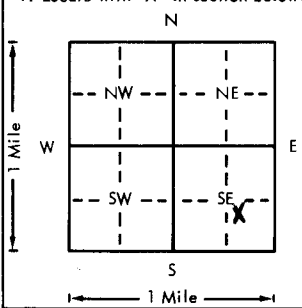


USE TYPEWRITER OR BALL
POINT PEN-PRESS FIRMLY,
PRINT CLEARLY.

WATER WELL RECORD
KSA 82a-1201-1215

Kansas Department of Health and
Environment-Division of Environment
(Water well Contractors)
Topeka, Kansas 66620

1. Location of well:		County Pawnee	Fraction NW 1/4 SE 1/4 SE 1/4	Section number 21	Township number T 22 S	Range number R 16 E
2. Distance and direction from nearest town or city: 4-5 of Larned, Ks. Street address of well location if in city:				3. Owner of well: Pawnee Beef Bldrs., Inc. R.R. or street: At. 2 City, state, zip code: Larned, Ks. 67550		
4. Locate with "X" in section below:		Sketch map:		6. Bore hole dia. 2 1/2 in. Completion date Well depth 82 ft. 8-7-78		
				7. <input type="checkbox"/> Cable tool <input checked="" type="checkbox"/> Rotary <input type="checkbox"/> Driven <input type="checkbox"/> Dug <input type="checkbox"/> Hollow rod <input type="checkbox"/> Jetted <input type="checkbox"/> Bored <input type="checkbox"/> Reverse rotary		
5. Type and color of material				From	To	8. Use: <input type="checkbox"/> Domestic <input type="checkbox"/> Public supply <input type="checkbox"/> Industry <input checked="" type="checkbox"/> Irrigation <input type="checkbox"/> Air conditioning <input type="checkbox"/> Stock <input type="checkbox"/> Lawn <input type="checkbox"/> Oil field water <input type="checkbox"/> Other
Top soil				0	3	9. Casing: Material Steel Height: Above or below Threaded <input type="checkbox"/> Welded <input type="checkbox"/> Surface 18 in. RMP <input type="checkbox"/> PVC <input type="checkbox"/> Weight <input type="checkbox"/> lbs./ft. Dia. 1 1/2 in. to 82 ft. depth Wall Thickness: inches or Dia. <input type="checkbox"/> in. to <input type="checkbox"/> ft. depth gage No. 7
Brown clay				3	7	10. Screen: Manufacturer's name Deere Type Steel Dia. Slot/gauge 3/16 Length 22 Set between 60 ft. and 82 ft. ft. and <input type="checkbox"/> ft. Gravel pack? <input checked="" type="checkbox"/> Size range of material 1/2 to 3/4
Brown clay sand mixed				7	50	11. Static water level: 32 ft. below land surface Date 6-30-76
Brown clay				50	60	12. Pumping level below land surfaces: 48 ft. after 1 hrs. pumping 200 g.p.m. ft. after <input type="checkbox"/> hrs. pumping <input type="checkbox"/> g.p.m. Estimated maximum yield 500 g.p.m.
Med. coarse sand & gravel				60	65	13. Water sample submitted: <input checked="" type="checkbox"/> Yes <input type="checkbox"/> No Date 6-30-76
Sand & gravel				65	82	14. Well head completion: <input type="checkbox"/> Pitless adapter <input type="checkbox"/> Inches above grade
Brown clay				82	85	15. Well grouted? <input checked="" type="checkbox"/> With: <input checked="" type="checkbox"/> Neat cement <input type="checkbox"/> Bentonite <input type="checkbox"/> Concrete Depth: From 0 ft. to 10 ft.
						16. Nearest source of possible contamination: ft. 200 Direction East Type Feedyard Well disinfected upon completion? HTH Yes <input type="checkbox"/> No
						17. Pump: <input type="checkbox"/> Not installed Manufacturer's name WHR Model number 6-10CM HP 40 Volts 230 Length of drop pipe 70 ft. capacity <input type="checkbox"/> g.p.m. Type: <input type="checkbox"/> Submersible <input type="checkbox"/> Turbine <input type="checkbox"/> Jet <input type="checkbox"/> Reciprocating <input type="checkbox"/> Centrifugal <input type="checkbox"/> Other
(Use a second sheet if needed)						
18. Elevation:		19. Remarks:		20. Water well contractor's certification: This well was drilled under my jurisdiction and this report is true to the best of my knowledge and belief. Rosencrantz-Bemis 134 Business name License No. Address Great Bend, Ks. 67530 Signed Sandy K. Lopez Date 9-19-78 Authorized representative		
Topography: <input type="checkbox"/> Hill <input type="checkbox"/> Slope <input checked="" type="checkbox"/> Upland <input type="checkbox"/> Valley						

Forward the white, blue and pink copies to the Department of Health and Environment

Form WWC-5