


WATER WELL RECORD

Form WWC-5

Division of Water Resources App. No.

1 LOCATION OF WATER WELL: County: Pawnee, Fraction 1/4 SE 1/4 NW 1/4 NW 1/4, Section Number 3, Township No. T 22 S, Range Number R 16, Global Positioning System (GPS) information: Latitude: 38.17163, Longitude: 099.07458, Elevation: ... Datum: WGS 84, NAD 83, NAD 27, Collection Method: GPS unit, Digital Map/Photo, Topographic Map, Land Survey, Est. Accuracy: <3 m, 3-5 m, 5-15 m, >15 m

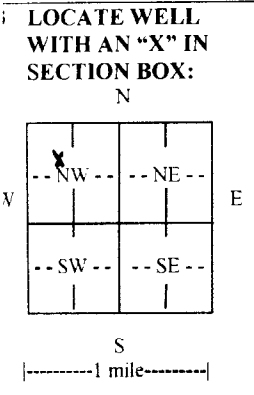

4 DEPTH OF COMPLETED WELL 55 ft. Depth(s) Groundwater Encountered (1) 19 ft. (2) 30 ft. (3) 10-16-15 ft. WELL'S STATIC WATER LEVEL 19 ft. below land surface measured on mo/day/yr. 10-16-15. Pump test data: Well water was 30 ft. after 3 hours pumping, 869 gpm. EST. YIELD 900 gpm. Well water was 30 1/2 ft. after 3 1/2 hours pumping, 900 gpm. Bore Hole Diameter 40 in. to 55 ft., and ... in. to ... ft. WELL WATER TO BE USED AS: Irrigation, Industrial, Domestic-lawn & garden, Monitoring well. Was a chemical/bacteriological sample submitted to Department? No. Water well disinfected? Yes.

5 TYPE OF CASING USED: PVC. CASING JOINTS: Glued. Casing diameter 16 in. to 55 ft., Diameter ... in. to ... ft. Casing height above land surface 18 in., Weight Sch 40 lbs./ft., Wall thickness or gauge No. TYPE OF SCREEN OR PERFORATION MATERIAL: Stainless Steel, PVC. SCREEN OR PERFORATION OPENINGS ARE: Saw cut. SCREEN-PERFORATED INTERVALS: From 45 ft. to 25 ft., From ... ft. to ... ft. GRAVEL PACK INTERVALS: From 55 ft. to 20 ft., From ... ft. to ... ft.

6 GROUT MATERIAL: Bentonite. Grout Intervals: From ... ft. to ... ft., From 20 ft. to 0 ft., From ... ft. to ... ft. What is the nearest source of possible contamination: Other (specify below).

Table with columns: FROM, TO, LITHOLOGIC LOG, FROM, TO, LITHO. LOG (cont.) or PLUGGING INTERVALS. Rows: 0-2 Top soil, 2-18 Gravel- small to med, 18-19 Brown clay streak, 19-46 Gravel- small to med, 46-47 Big gravel, 47-55 Brown clay.

7 CONTRACTOR'S OR LANDOWNER'S CERTIFICATION: This water well was constructed, reconstructed, or plugged under my jurisdiction and was completed on (mo/day/year) 10-25-15 and this record is true to the best of my knowledge and belief. Kansas Water Well Contractor's License No. 134. This Water Well Record was completed on (mo/day/year) 11-5-15 under the business name of Rosencrantz- Bemis Ent Inc by (signature) Thom Alay.

INSTRUCTIONS: Use typewriter or ball point pen. PLEASE PRESS FIRMLY and PRINT clearly. Please fill in blanks and check the correct answers. Send one copy to Kansas Department of Health and Environment, Bureau of Water, Geology Section, 1000 SW Jackson St., Suite 420, Topeka, Kansas 66612-1367. Telephone 785-296-5524. Send one copy to WATER WELL OWNER and retain one for your records. Include fee of \$5.00 for each constructed well. Visit us at http://www.kdheks.gov/waterwell/index.html