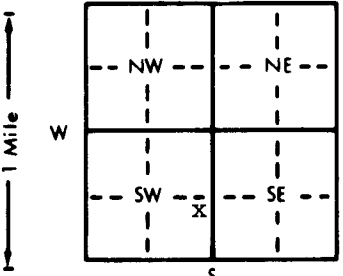


1 LOCATION OF WATER WELL:		Fraction	Section Number	Township Number	Range Number
County: Pawnee		NE 1/4 SE 1/4 SW 1/4	14	T 22 S	R 17 E/W
Distance and direction from nearest town or city street address of well if located within city? Approximately 3 1/2 miles west and 3 miles south of Larned					
2 WATER WELL OWNER:		Rebecca H. Lewis			
RR#, St. Address, Box # :		Route 3 - Box 48			
City, State, ZIP Code :		Larned, KS 67550			
3 LOCATE WELL'S LOCATION WITH AN "X" IN SECTION BOX:		4 DEPTH OF COMPLETED WELL: 160 ft. ELEVATION: unknown			
		Depth(s) Groundwater Encountered 1. ft. 2. ft. 3. ft.			
		WELL'S STATIC WATER LEVEL 18 ft. below land surface measured on mo/day/yr 2-22-96			
		Pump test data: Well water was not ch'd ft. after hours pumping gpm			
		Est. Yield unknown gpm: Well water was ft. after hours pumping gpm			
Bore Hole Diameter 24 in. to 160 ft. and in. to ft.		WELL WATER TO BE USED AS:			
1 Domestic		3 Feedlot	6 Oil field water supply	9 Dewatering	12 Other (Specify below)
2 Irrigation		4 Industrial	7 Lawn and garden only	10 Monitoring well	
Was a chemical/bacteriological sample submitted to Department? Yes No X		If yes, mo/day/yr sample was submitted			
5 TYPE OF BLANK CASING USED:		CASING JOINTS: Glued X Clamped			
1 Steel		3 RMP (SR)	6 Asbestos-Cement	9 Other (specify below)	Welded
2 PVC		4 ABS	7 Fiberglass		Threaded
Blank casing diameter 16 in. to 99 ft. Dia		in. to ft. Dia in. to ft.			
Casing height above land surface 12 in. weight 16, 15 lbs./ft. Wall thickness or gauge No. 500					
TYPE OF SCREEN OR PERFORATION MATERIAL:		7 PVC 10 Asbestos-cement			
1 Steel		3 Stainless steel	5 Fiberglass	8 RMP (SR)	11 Other (specify)
2 Brass		4 Galvanized steel	6 Concrete tile	9 ABS	12 None used (open hole)
SCREEN OR PERFORATION OPENINGS ARE:		5 Gauzed wrapped 8 Saw cut 11 None (open hole)			
1 Continuous slot		3 Mill slot	6 Wire wrapped	9 Drilled holes	
2 Louvered shutter		4 Key punched	7 Torch cut	10 Other (specify)	
SCREEN-PERFORATED INTERVALS:		From 99 ft. to 159 ft. From ft. to ft.			
GRAVEL PACK INTERVALS:		From 20 ft. to 160 ft. From ft. to ft.			
6 GROUT MATERIAL:		1 Neat cement 2 Cement grout 3 Bentonite 4 Other			
Grout intervals: From 0 ft. to 20 ft. From ft. to ft.					
What is the nearest source of possible contamination:		10 Livestock pens 14 Abandoned water well			
1 Septic tank		4 Lateral lines	7 Pit privy	11 Fuel storage	15 Oil well/Gas well
2 Sewer lines		5 Cess pool	8 Sewage lagoon	12 Fertilizer storage	16 Other (specify below)
3 Watertight sewer lines		6 Seepage pit	9 Feedyard	13 Insecticide storage	None known
Direction from well?		How many feet?			
FROM	TO	LITHOLOGIC LOG	FROM	TO	PLUGGING INTERVALS
0	2	Topsoil			
2	4	Clay, sandy, silty			
4	34	Sand and gravel, medium, coarse			
34	50	Clay, tannish-gray			
50	60	Clay, brown			
60	94	Clay, gray			
94	99	Sand, fine, medium			
99	115	Sand and gravel, fine, medium			
115	116	Clay streak			
116	142	Sand and gravel, medium, coarse			
142	143	Clay streak			
143	153	Sand and gravel, fine, medium			
153	160	Sand and gravel, medium to coarse			
7 CONTRACTOR'S OR LANDOWNER'S CERTIFICATION: This water well was (1) constructed, (2) reconstructed, or (3) plugged under my jurisdiction and was completed on (mo/day/year) 2-22-96 and this record is true to the best of my knowledge and belief. Kansas Water Well Contractor's License No. 185 This Water Well Record was completed on (mo/day/yr) 2-23-96 under the business name of Clarke Well & Equipment, Inc. by (signature) [Signature]					
INSTRUCTIONS: Use typewriter or ball point pen. PLEASE PRESS FIRMLY and PRINT clearly. Please fill in blanks, underline or circle the correct answers. Send top three copies to Kansas Department of Health and Environment, Bureau of Water, Topeka, Kansas 66620-0001. Telephone: 913-296-5545. Send one to WATER WELL OWNER and retain one for your records.					