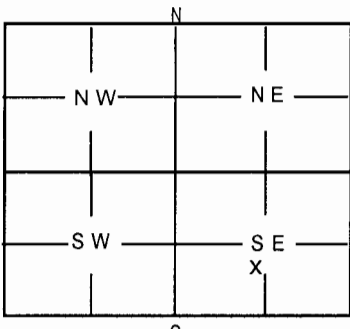


1	LOCATION OF WATER WELL:	Fraction	Section	Number	Township	Number	Range	Number
County: Pawnee		NE 1/4 SW 1/4 SE 1/4	2		T 22 S		R 17 E	W

Distance and direction from nearest town or city street address of well if located within city?
Approximately 2 1/4 miles west and 3/4 mile south of Larned


2	WATER WELL OWNER: Larned State Hospital RR#, St. Address, Box # Route 3 - Box 89 City, State, ZIP Code Larned, KS 67550 <div style="float: right; text-align: right;"> Board of Agriculture, Division of Water Resources Application Number: </div>
---	---

3	MARK WELL'S LOCATION WITH AN "X" IN SECTION BOX: <div style="text-align: center;">  </div>	4 DEPTH OF WELL 42.6 ft. WELL'S STATIC WATER LEVEL 11.6 ft. WELL WAS USED AS: <table style="width:100%;"> <tr> <td>1 Domestic</td> <td>5 Public Water Supply</td> <td>9 Dewatering</td> </tr> <tr> <td>2 Irrigation</td> <td>6 Oil Field Water Supply</td> <td>10 Monitoring Well</td> </tr> <tr> <td>3 Feedlot</td> <td>7 Domestic (Lawn & Garden)</td> <td>11 Injection Well</td> </tr> <tr> <td>4 Industrial</td> <td>8 Air Conditioning</td> <td>12 Other Test Hole</td> </tr> </table> Was a chemical / bacteriological sample submitted to Department? Yes _____ No <input checked="" type="checkbox"/> If yes, mo/day/yr sample was submitted _____ Water Well Disinfected: Yes <input checked="" type="checkbox"/> No _____	1 Domestic	5 Public Water Supply	9 Dewatering	2 Irrigation	6 Oil Field Water Supply	10 Monitoring Well	3 Feedlot	7 Domestic (Lawn & Garden)	11 Injection Well	4 Industrial	8 Air Conditioning	12 Other Test Hole
1 Domestic	5 Public Water Supply	9 Dewatering												
2 Irrigation	6 Oil Field Water Supply	10 Monitoring Well												
3 Feedlot	7 Domestic (Lawn & Garden)	11 Injection Well												
4 Industrial	8 Air Conditioning	12 Other Test Hole												

5	TYPE OF BLANK CASING USED: <table style="width:100%;"> <tr> <td>1 Steel</td> <td>3 RMP (SR)</td> <td>5 Wrought</td> <td>7 Fiberglass</td> <td>9 Other (Specify below)</td> </tr> <tr> <td>2 PVC</td> <td>4 ABS</td> <td>6 Asbestos-Cement</td> <td>8 Concrete Tile</td> <td></td> </tr> </table> Blank casing diameter 2 1/2 in. Was casing pulled? Yes _____ No <input checked="" type="checkbox"/> Casing height above or below land surface 48 in. If yes, how much Cut off	1 Steel	3 RMP (SR)	5 Wrought	7 Fiberglass	9 Other (Specify below)	2 PVC	4 ABS	6 Asbestos-Cement	8 Concrete Tile	
1 Steel	3 RMP (SR)	5 Wrought	7 Fiberglass	9 Other (Specify below)							
2 PVC	4 ABS	6 Asbestos-Cement	8 Concrete Tile								

6	GROUT PLUG MATERIAL: 1 Neat Cement 2 Cement grout 3 Bentonite 4 Other Bentonite Holeplug Grout Plug Intervals: From _____ ft. to _____ ft., From _____ ft. to _____ ft. From 42.6 ft. to 4 ft. What is the nearest source of possible contamination: <table style="width:100%;"> <tr> <td>1 Septic tank</td> <td>6 Seepage pit</td> <td>11 Fuel storage</td> <td>16 Other (specify below)</td> </tr> <tr> <td>2 Sewer lines</td> <td>7 Pit privy</td> <td>12 Fertilizer storage</td> <td></td> </tr> <tr> <td>3 Watertight sewer lines</td> <td>8 Sewage lagoon</td> <td>13 Insecticide storage</td> <td>None known</td> </tr> <tr> <td>4 Lateral lines</td> <td>9 Feedyard</td> <td>14 Abandoned water well</td> <td></td> </tr> <tr> <td>5 Cess Pool</td> <td>10 Livestock pens</td> <td>15 Oil well/Gas well</td> <td></td> </tr> </table> Direction from well? _____ How many feet? _____	1 Septic tank	6 Seepage pit	11 Fuel storage	16 Other (specify below)	2 Sewer lines	7 Pit privy	12 Fertilizer storage		3 Watertight sewer lines	8 Sewage lagoon	13 Insecticide storage	None known	4 Lateral lines	9 Feedyard	14 Abandoned water well		5 Cess Pool	10 Livestock pens	15 Oil well/Gas well	
1 Septic tank	6 Seepage pit	11 Fuel storage	16 Other (specify below)																		
2 Sewer lines	7 Pit privy	12 Fertilizer storage																			
3 Watertight sewer lines	8 Sewage lagoon	13 Insecticide storage	None known																		
4 Lateral lines	9 Feedyard	14 Abandoned water well																			
5 Cess Pool	10 Livestock pens	15 Oil well/Gas well																			

FROM	TO	PLUGGING MATERIALS
42.6	4	Bentonite Holeplug
4	0	Compacted Soil

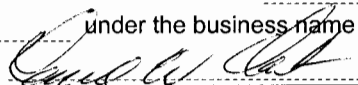7	CONTRACTOR'S OR LANDOWNER'S CERTIFICATION: This water well was plugged under my jurisdiction and was completed on (mo/day/year) 12-27-04 and this record is true to the best of my knowledge and belief. Kansas Water Well Contractor's License No. 185 This Water Well Record was completed on (mo/day/year) 1-4-05 under the business name of Clarke Well & Equipment, Inc. by (signature) 
---	---

INSTRUCTIONS: Use typewriter or ball point pen. Please press firmly and print clearly. Please fill in blanks, underline or circle the correct answers. Send top three copies to Kansas Department of Health & Environment, Bureau of Water, Topeka, Kansas 66620-0001. Telephone: 785/296-3565. Send one to Water Well Owner and retain one for your records.