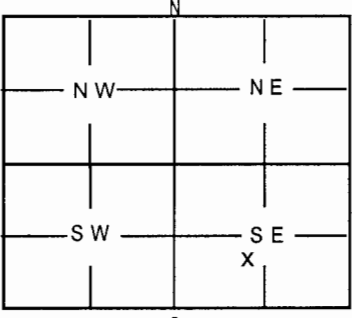


1	LOCATION OF WATER WELL:	Fraction	Section	Number	Township	Number	Range	Number																								
	County: <b>Pawnee</b>	<b>NE 1/4 SW 1/4 SE 1/4</b>	<b>2</b>		<b>T 22 S</b>		<b>R 17 E</b>	<b>W</b>																								
Distance and direction from nearest town or city street address of well if located within city? <b>Approximately 2 1/4 miles west and 3/4 mile south of Larned</b>																																
2	WATER WELL OWNER: <b>Larned State Hospital</b> RR#, St. Address, Box # <b>Route 3 - Box 89</b> City, State, ZIP Code <b>Larned, KS 67550</b>																															
Board of Agriculture, Division of Water Resources Application Number:																																
3	MARK WELL'S LOCATION WITH AN "X" IN SECTION BOX:  <div style="text-align: center;">  </div>		4 DEPTH OF WELL <b>36.4</b> ft.  WELL'S STATIC WATER LEVEL <b>11.3</b> ft.  WELL WAS USED AS: <table style="width:100%;"> <tr> <td>1 Domestic</td> <td>5 Public Water Supply</td> <td>9 Dewatering</td> </tr> <tr> <td>2 Irrigation</td> <td>6 Oil Field Water Supply</td> <td><b>10 Monitoring Well</b></td> </tr> <tr> <td>3 Feedlot</td> <td>7 Domestic (Lawn &amp; Garden)</td> <td>11 Injection Well</td> </tr> <tr> <td>4 Industrial</td> <td>8 Air Conditioning</td> <td>12 Other</td> </tr> </table> Was a chemical / bacteriological sample submitted to Department? Yes <input type="checkbox"/> No <input checked="" type="checkbox"/> If yes, mo/day/yr sample was submitted _____  Water Well Disinfected: Yes <input checked="" type="checkbox"/> No <input type="checkbox"/>							1 Domestic	5 Public Water Supply	9 Dewatering	2 Irrigation	6 Oil Field Water Supply	<b>10 Monitoring Well</b>	3 Feedlot	7 Domestic (Lawn & Garden)	11 Injection Well	4 Industrial	8 Air Conditioning	12 Other											
1 Domestic	5 Public Water Supply	9 Dewatering																														
2 Irrigation	6 Oil Field Water Supply	<b>10 Monitoring Well</b>																														
3 Feedlot	7 Domestic (Lawn & Garden)	11 Injection Well																														
4 Industrial	8 Air Conditioning	12 Other																														
5	TYPE OF BLANK CASING USED: <table style="width:100%;"> <tr> <td>1 Steel</td> <td>3 RMP (SR)</td> <td>5 Wrought</td> <td>7 Fiberglass</td> <td>9 Other (Specify below)</td> </tr> <tr> <td><b>2 PVC</b></td> <td>4 ABS</td> <td>6 Asbestos-Cement</td> <td>8 Concrete Tile</td> <td></td> </tr> </table> Blank casing diameter <b>5</b> in. Was casing pulled? Yes <input type="checkbox"/> No <input checked="" type="checkbox"/> If yes, how much <b>Cut off</b> Casing height above or <b>below</b> land surface <b>48</b> in.								1 Steel	3 RMP (SR)	5 Wrought	7 Fiberglass	9 Other (Specify below)	<b>2 PVC</b>	4 ABS	6 Asbestos-Cement	8 Concrete Tile															
1 Steel	3 RMP (SR)	5 Wrought	7 Fiberglass	9 Other (Specify below)																												
<b>2 PVC</b>	4 ABS	6 Asbestos-Cement	8 Concrete Tile																													
6	GROUT PLUG MATERIAL: 1 Neat Cement 2 Cement grout 3 Bentonite 4 Other <b>Bentonite Holeplug</b> Grout Plug Intervals: From _____ ft. to _____ ft., From _____ ft. to _____ ft. From <b>20</b> ft. to <b>4</b> ft. What is the nearest source of possible contamination: <table style="width:100%;"> <tr> <td>1 Septic tank</td> <td>6 Seepage pit</td> <td>11 Fuel storage</td> <td>16 Other (specify below)</td> </tr> <tr> <td>2 Sewer lines</td> <td>7 Pit privy</td> <td>12 Fertilizer storage</td> <td></td> </tr> <tr> <td>3 Watertight sewer lines</td> <td>8 Sewage lagoon</td> <td>13 Insecticide storage</td> <td><b>None known</b></td> </tr> <tr> <td>4 Lateral lines</td> <td>9 Feedyard</td> <td>14 Abandoned water well</td> <td></td> </tr> <tr> <td>5 Cess Pool</td> <td>10 Livestock pens</td> <td>15 Oil well/Gas well</td> <td></td> </tr> </table> Direction from well? _____ How many feet? _____								1 Septic tank	6 Seepage pit	11 Fuel storage	16 Other (specify below)	2 Sewer lines	7 Pit privy	12 Fertilizer storage		3 Watertight sewer lines	8 Sewage lagoon	13 Insecticide storage	<b>None known</b>	4 Lateral lines	9 Feedyard	14 Abandoned water well		5 Cess Pool	10 Livestock pens	15 Oil well/Gas well					
1 Septic tank	6 Seepage pit	11 Fuel storage	16 Other (specify below)																													
2 Sewer lines	7 Pit privy	12 Fertilizer storage																														
3 Watertight sewer lines	8 Sewage lagoon	13 Insecticide storage	<b>None known</b>																													
4 Lateral lines	9 Feedyard	14 Abandoned water well																														
5 Cess Pool	10 Livestock pens	15 Oil well/Gas well																														
<table border="1" style="width:100%; border-collapse: collapse;"> <thead> <tr> <th style="width:10%;">FROM</th> <th style="width:10%;">TO</th> <th style="width:80%;">PLUGGING MATERIALS</th> </tr> </thead> <tbody> <tr> <td style="text-align: center;">36.4</td> <td style="text-align: center;">20</td> <td>Chlorinated Sand</td> </tr> <tr> <td style="text-align: center;">20</td> <td style="text-align: center;">4</td> <td>Bentonite Holeplug</td> </tr> <tr> <td style="text-align: center;">4</td> <td style="text-align: center;">0</td> <td>Compacted Soil</td> </tr> <tr><td> </td><td> </td><td> </td></tr> <tr><td> </td><td> </td><td> </td></tr> <tr><td> </td><td> </td><td> </td></tr> <tr><td> </td><td> </td><td> </td></tr> </tbody> </table>									FROM	TO	PLUGGING MATERIALS	36.4	20	Chlorinated Sand	20	4	Bentonite Holeplug	4	0	Compacted Soil												
FROM	TO	PLUGGING MATERIALS																														
36.4	20	Chlorinated Sand																														
20	4	Bentonite Holeplug																														
4	0	Compacted Soil																														
7	CONTRACTOR'S OR LANDOWNER'S CERTIFICATION: This water well was plugged under my jurisdiction and was completed on (mo/day/year) <b>12-27-04</b> and this record is true to the best of my knowledge and belief. Kansas Water Well Contractor's License No. <b>185</b> This Water Well Record was completed on (mo/day/year) <b>1-3-05</b> under the business name of <b>Clarke Well &amp; Equipment, Inc.</b> by (signature) <i>[Signature]</i>																															
INSTRUCTIONS: Use typewriter or ball point pen. Please press firmly and print clearly. Please fill in blanks, underline or circle the correct answers. Send top three copies to Kansas Department of Health & Environment, Bureau of Water, Topeka, Kansas 66620-0001. Telephone: 785/296-3565. Send one to Water Well Owner and retain one for your records.																																