

1	LOCATION OF WATER WELL:	Fraction	Section Number	Township Number	Range Number
County: Pawnee	C/S $\frac{1}{2}$ XX SW $\frac{1}{4}$ SW $\frac{1}{4}$	22	T 22 S	R 17 XX W	


Distance and direction from nearest town or city street address of well if located within city?

2½ North, 3 East of Garfield

2	WATER WELL OWNER:	Cleary Petroleum	Kraig Froetschner	PNWW3209
	RR#, St. Address, Box # :	2601 NW Expressway	RR 1	Board of Agriculture, Division of Water Resources
	City, State, ZIP Code :	Suite 801W Oklahoma City, Ok. 73112	Garfield, Ks. 67529	Application Number: 20060088

3 LOCATE WELL'S LOCATION WITH 4 DEPTH OF COMPLETED WELL 115 ft. ELEVATION:

AN "X" IN SECTION BOX:

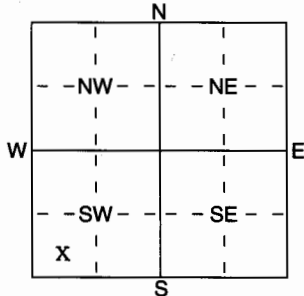

Depth(s) Groundwater Encountered 1 ft. 2 ft. 3 ft.
WELL'S STATIC WATER LEVEL 27 ft. below land surface measured on mo/day/yr 3-22-06

Pump test data: Well water was ft. after hours pumping gpm
 Est. Yield N/A gpm: Well water was ft. after hours pumping gpm

WELL WATER TO BE USED AS:			
1 Domestic	3 Feedlot	6 <u>Oil field water supply</u>	9 Dewatering
2 Irrigation	4 Industrial	7 Domestic (lawn & garden)	10 Monitoring well
		8 Air conditioning	11 Injection well
			12 Other (Specify below)

Was a chemical/bacteriological sample submitted to Department? Yes No X...; If yes, mo/day/yr sample was submitted
Water Well Disinfected? Yes HTH No

5	TYPE OF BLANK CASING USED:		5 Wrought iron	8 Concrete tile	CASING JOINTS: Glued ☒ Clamped	
	1 Steel	3 RMP (SR)	6 Asbestos-Cement	9 Other (specify below)		Welded
	2 PVC	4 ABS	7 Fiberglass			Threaded

Blank casing diameter 5 in. to 85 ft., Dia in. to ft., Dia in. to ft.

Casing height above land surface 36 in., weight SDR-26 lbs./ft. Wall thickness or gauge No.

TYPE OF SCREEN OR PERFORATION MATERIAL:	7 PVC	10 Asbestos-Cement
---	-------	--------------------

1 Steel	3 Stainless Steel	5 Fiberglass	8 RMP (SR)	11 Other (Specify)
2 Brass	4 Galvanized Steel	6 Concrete tile	9 ABS	12 None used (open hole)

SCREEN OR PERFORATION OPENINGS ARE:

5. Gauzed/wrapped	8. Saw cut	11. None (open hole)
-------------------	------------	----------------------

1 Continuous slot	3 Mill slot	6 Saw cut	11 None (open hole)
2 Louvered shutter	4 Key punched	9 Drilled holes	
	5 Glazed wrapped	10 Other (specify)	ft.
	6 Wire wrapped		
	7 Torch cut		

SCREEN-PERFORATED INTERVALS: From 115 ft. to 85 ft. From _____ ft. to _____ ft.

GRAVEL PACK INTERVALS:

6	GROUT MATERIAL:	1 Neat cement	2 Cement grout	3 Bentonite	4 Other <u>Hole plug</u>
---	-----------------	---------------	----------------	-------------	--------------------------

Grout Intervals: From 20 ft. to 0 ft., From _____ ft. to _____ ft., From _____ ft. to _____ ft.

What is the nearest source of possible contamination: 10 Livestock pens 14 Abandoned water well

1 Septic tank	4 Lateral lines	7 Pit privy	11 Fuel storage	15 Oil well/Gas well
2 Sewer lines	5 Cess pool	8 Sewage lagoon	12 Fertilizer storage	16 Other (specify below)

3 Watertight sewer lines	6 Seepage pit	9 Feedyard	13 Insecticide storage	
--------------------------	---------------	------------	------------------------	-------

Direction from well?	East	How many feet?	100
----------------------	------	----------------	-----

[illegible]

7] CONTRACTOR'S OR LANDOWNER'S CERTIFICATION: This water well was (1) constructed, (2) reconstructed, or (3) plugged under my jurisdiction and was completed on (mo/day/year) 3-22-06 and this record is true to the best of my knowledge and belief. Kansas Water Well Contractor's Licence No 134 This Water Well Record was completed on (mo/day/yr) 3-27-06 under the business name of Rosencrantz- Bemis by (signature) [Signature]