


1 LOCATION OF WATER WELL: Fraction NE 1/4 SE 1/4 NE 1/4 Section Number 2 Township Number T 22 S Range Number R 17 **EW**
 County: Pawnee
 Distance and direction from nearest town or city street address of well if located within city?
2 1/2 miles west of Larned, Ks.

2 WATER WELL OWNER: Larned State Hospital -Laundry Board of Agriculture, Division of Water Resources
 RR#, St. Address, Box #: Larned, Ks. 67550 Application Number: A -5265
 City, State, ZIP Code:

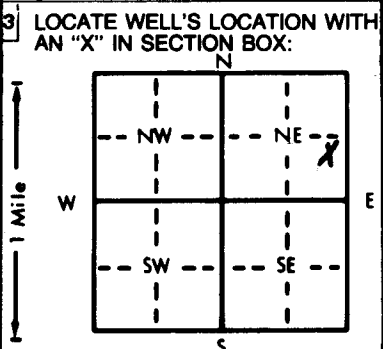

4 DEPTH OF COMPLETED WELL... 41 1/2 ft. ELEVATION:
 Depth(s) Groundwater Encountered 1... 21 ft. 2... ft. 3... ft.
 WELL'S STATIC WATER LEVEL... 24 ft. below land surface measured on mo/day/yr 8-25-86
 Pump test data: Well water was ft. after hours pumping gpm
 Est. Yield... 150 gpm: Well water was 29 ft. after 4 hours pumping gpm
 Bore Hole Diameter... 30 in. to 41 1/2 ft., and in. to ft.
 WELL WATER TO BE USED AS: 5 Public water supply 8 Air conditioning 11 Injection well
 1 Domestic 3 Feedlot 6 Oil field water supply 9 Dewatering 12 Other (Specify below)
 2 Irrigation 4 Industrial 7 Lawn and garden only 10 Observation well Extraction well
 Was a chemical/bacteriological sample submitted to Department? Yes.....No.....X;; If yes, mo/day/yr sample was submitted
 Water Well Disinfected? Yes hth No

5 TYPE OF CASING USED: 5 Wrought iron 8 Concrete tile CASING JOINTS: Glued Clamped
1 Steel 3 RMP (SR) 6 Asbestos-Cement 9 Other (specify below) Welded X
 2 PVC 4 ABS 7 Fiberglass Threaded.....
 Blank casing diameter... 10 in. to 31 1/2 ft., Dia..... in. to ft., Dia..... in. to ft.
 Casing height above land surface... 12 in., weight 34.24 lbs./ft. Wall thickness or gauge No.
 TYPE OF SCREEN OR PERFORATION MATERIAL: 7 PVC 10 Asbestos-cement
X Stainless steel 3 Stainless steel 5 Fiberglass 8 RMP (SR) 11 Other (specify)
 2 Brass 4 Galvanized steel 6 Concrete tile 9 ABS 12 None used (open hole)
 SCREEN OR PERFORATION OPENINGS ARE: 5 Gauzed wrapped 8 Saw cut 11 None (open hole)
 1 Continuous slot 3 Mill slot 6 Wire wrapped 9 Drilled holes
 2 Louvered shutter 4 Key punched 7 Torch cut 10 Other (specify)
 SCREEN-PERFORATED INTERVALS: From... 31 1/2 ft. to 41 1/2 ft., From ft. to ft.
 From ft. to ft., From ft. to ft.
 GRAVEL PACK INTERVALS: From... 20 ft. to 41 1/2 ft., From ft. to ft.
 From ft. to ft., From ft. to ft.

6 GROUT MATERIAL: 1 Neat cement 2 Cement grout 3 Bentonite 4 Other
 Grout Intervals: From... XXXXXXXXXXXX ft. to XXXXXXXXXXXX ft., From 0 ft. to 20 ft., From ft. to ft.
 What is the nearest source of possible contamination:
 1 Septic tank 4 Lateral lines 7 Pit privy 10 Livestock pens 14 Abandoned water well
 2 Sewer lines 5 Cess pool 8 Sewage lagoon 11 Fuel storage 15 Oil well/Gas well
 3 Watertight sewer lines 6 Seepage pit 9 Feedyard 12 Fertilizer storage 16 Other (specify below)
 13 Insecticide storage
 Direction from well? south How many feet? 55

FROM	TO	LITHOLOGIC LOG	FROM	TO	LITHOLOGIC LOG
0	3	Top soil			
3	21	Brown clay			
21	24	Brown clay and sand mixed			
24	33	Sand and gravel			
33	34	clay streaks			
34	41 1/2	Sand and gravel			
41 1/2		Yellow brown blue gray clay			

7 CONTRACTOR'S OR LANDOWNER'S CERTIFICATION: This water well was (1) constructed, (2) reconstructed, or (3) plugged under my jurisdiction and was completed on (mo/day/year) 9-24-86 and this record is true to the best of my knowledge and belief. Kansas Water Well Contractor's License No. 134 This Water Well Record was completed on (mo/day/yr) 11-17-86 under the business name of Rosencrantz-Bemis by (signature) Fredia Rodson

INSTRUCTIONS: Use typewriter or ball point pen. PLEASE PRESS FIRMLY and PRINT clearly. Please fill in blanks, underline or circle the correct answers. Send top three copies to Kansas Department of Health and Environment, Office of Oil Field and Environmental Geology, Regulation and Permitting Section, Topeka, Kansas 66620-7500, Telephone: 913-862-9360. Send one to WATER WELL OWNER and retain one for your records.

OFFICE USE ONLY T 22 R 17 SEC. 2