USE TYPEWRITER OR BALL POINT PEN-PRESS FIRMLY, PRINT CLEARLY.

T R EW sec 1/4 1/4 1/4 No.

WATER WELL RECORD
KSA 82a-1201-1215

Kansas State Dept. Of Health
(Water Well Contractors)
Forbes-Bldg. 740
Topeka, Kansas 66620

1 Location of well:	County	Township name	Fraction	Section number	Town number	Range number
	Pawnee		SW NE 1/4	6	22 S	17 W

Distance and direction from nearest town or city: 7 W.

Street address of well location if in city: Larned, Kan

3 Owner of well: Melvin Bryant

Address: 903 W. 5th Larned, Kan.

Locate with "X" in section below:

Sketch map:

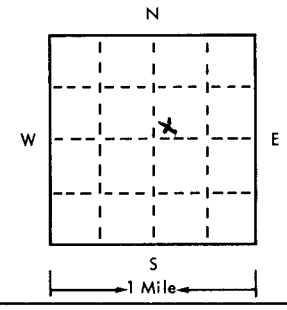

4 Well depth: 166 ft. Date of completion 1-25-75
Well diameter 28 in.

5 ☐ Cable tool ☐ Rotary ☐ Driven ☐ Dug
☐ Hollow rod ☐ Jetted ☐ Bored ☒ Reverse rotary

6 Use: ☐ Domestic ☐ Public supply ☐ Industry
☒ Irrigation ☐ Air conditioning ☐ Commercial
☐ Test well ☐ _____

7 Casing: Material BI Height: above/below
Threaded ☐ Welded ☒ Surface 24 in.
Diam. Weight ____ lbs./ft.
16 in. to 106 ft. depth Drive shoe? ☐ Yes ☒ No
____ in. to ____ ft. depth

2

Type and color of material	From	To
Top Soil & Clay	0	26
Sand-Gravel	26	42
Clay	42	94
Sand-Gravel-Clay	94	166
(use a second sheet if needed)		

8 Screen:
Manufacturer Doerr
Type Steel Dia. 16
Slot/gauze 1/8" Length 60
Set between 106 ft. and 166 ft.
Fittings:
Gravel pack ☒ Yes ☐ No Size range of material 3/16" - 3/4"

9 Static water level:
25 ft. below land surface Date 1-25-75

10 Pumping level below land surfaces:
75 ft. after 2 hrs. pumping 1250 g.p.m.
88 ft. after 4 hrs. pumping 1400 g.p.m.
Estimated maximum yield 1500 g.p.m.

11 Water sample submitted:
☐ Yes ☒ No Date ____

12 Well head completion: 24
☐ Pitless adapter ☒ Inches above grade

13 Well grouted? ☒ Yes ☐ No
☒ Neat cement ☐ Bentonite ☐ _____
Depth: From 0 ft. to 10 ft.

14 Nearest source of possible contamination: None
ft. ____ Direction ____ Type ____
Well disinfected upon completion? ☐ Yes ☒ No

15 Pump: ☒ Not installed
Manufacturer's name ____
Model number ____ HP ____ Volts ____
Length of drop pipe ____ ft. capacity ____ g.m.p.
Type:
☐ Submersible ☐ Turbine
☐ Jet ☐ Reciprocating
☐ Certrifugal ☐ Other

16 Remarks: elevation

Topography:
☐ Hill
☐ Slope
☐ Upland
☒ Valley

17 Water well contractor's certification:
This well was drilled under my jurisdiction and this report is true to the best of my knowledge and belief.
Kelly's Water Well Ser 186
Business name License No.
Address R. 1 Great Bend
Signed Kelly Price Date 1-28-75
Authorized representative

Forward the white, blue and pink copies to the Kansas State Dept. Of Health.

Form WWC-5

677-H