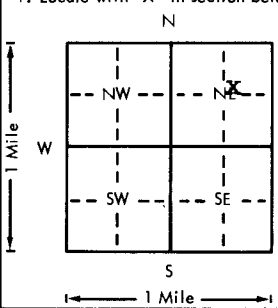


USE TYPEWRITER OR BALL  
POINT PEN-PRESS FIRMLY,  
PRINT CLEARLY.

WATER WELL RECORD  
KSA 82a-1201-1215

Kansas Department of Health and  
Environment-Division of Environment  
(Water well Contractors)  
Topeka, Kansas 66620

1. Location of well:		County <b>Pawnee</b>	Fraction <b>sw 1/4 ne 1/4 ne 1/4</b>	Section number <b>10</b>	Township number <b>T 22 S</b>	Range number <b>R 17 E</b>
2. Distance and direction from nearest town or city: <b>4-W of Larned, Ks. South side of rd.</b> Street address of well location if in city:				3. Owner of well: <b>Walter Lewis</b> R.R. or street: <b>Rt. 3</b> City, state, zip code: <b>Larned, Kansas 67550</b>		
4. Locate with "X" in section below: 				Sketch map:		
5. Type and color of material				From	To	
top soil				0	1	
dry sand & gravel				1	6	
clay				6	20	
fine sand				20	40	
clay				40	68	
good clean sand & gravel				68	105	
(Use a second sheet if needed)						
18. Elevation:		19. Remarks:				
Topography: ____ Hill ____ Slope ____ Upland <input checked="" type="checkbox"/> Valley		20. Water well contractor's certification: This well was drilled under my jurisdiction and this report is true to the best of my knowledge and belief. <b>Rosencrantz-Bemis</b> 134 Business name License No. Address <b>Great Bend, Ks. 67530</b> Signed <b>Sandy Kelame</b> Date <b>12-15-78</b> Authorized representative				

Forward the white, blue and pink copies to the Department of Health and Environment

Form WWC-5