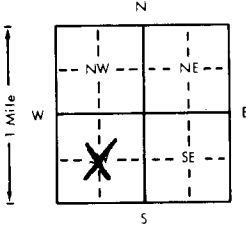


1 LOCATION OF WATER WELL		Fraction	Section Number		Township Number		Range Number	
County: <b>Pawnee</b>		$\frac{1}{4}$ $\frac{1}{4}$ <b>SW</b> $\frac{1}{4}$	<b>11</b>		<b>T 22 S</b>		<b>R 17 EW</b>	
Distance and direction from nearest town or city? <b>Larned - 3 South on Highway 56</b> <b>1/2 West - 1/2 North - 1/4 West</b>								
2 WATER WELL OWNER: <b>Robert Lewis</b>								
RR#, St. Address, Box # : City, State, ZIP Code : <b>Larned, KS 67550</b>								
Board of Agriculture, Division of Water Resources Application Number:								
3 DEPTH OF COMPLETED WELL: <b>145</b> ft. Bore Hole Diameter: <b>26</b> in. to <b>145</b> ft. and in. to ft.								
Well Water to be used as: 1 Domestic 3 Feedlot 5 Public water supply 8 Air conditioning 11 Injection well 2 Irrigation 4 Industrial 6 Oil field water supply 9 Dewatering 12 Other (Specify below) 7 Lawn and garden only 10 Observation well								
Well's static water level: <b>26</b> ft. below land surface measured on <b>September</b> month <b>19</b> day <b>1980</b> year								
Pump Test Data: Well water was <b>47</b> ft. after <b>2</b> hours pumping <b>1050</b> gpm Est. Yield <b>1750</b> gpm: Well water was <b>85</b> ft. after <b>3</b> hours pumping <b>1750</b> gpm								
4 TYPE OF BLANK CASING USED: 1 Steel 3 RMP (SR) 5 Wrought iron 8 Concrete tile Casing Joints: Glued Clamped 2 PVC 4 ABS 6 Asbestos-Cement 9 Other (specify below) Welded <b>X</b> 7 Fiberglass Threaded								
Blank casing dia <b>16</b> in. to <b>145</b> ft. Dia in. to ft. Dia in. to ft.								
Casing height above land surface <b>12</b> in. weight <b>36.4</b> lbs./ft. Wall thickness or gauge No <b>.219</b>								
TYPE OF SCREEN OR PERFORATION MATERIAL: 1 Steel 3 Stainless steel 5 Fiberglass 8 RMP (SR) 10 Asbestos-cement 2 Brass 4 Galvanized steel 6 Concrete tile 9 ABS 11 Other (specify) 12 None used (open hole)								
Screen or Perforation Openings Are: 1 Continuous slot 3 Mill slot 5 Gauzed wrapped 8 Saw cut 11 None (open hole) 2 Louvered shutter 4 Key punched 6 Wire wrapped 9 Drilled holes 7 Torch cut 10 Other (specify)								
Screen-Perforation Dia <b>16</b> in. to <b>145</b> ft. Dia in. to ft. Dia in. to ft.								
Screen-Perforated Intervals: <del>Screen 65-85</del> <del>Perf 85-95</del> <del>Screen 95-125</del> <del>Perf 125-130</del> <del>Screen 130-140</del> <del>Perf 140-145</del> ft. From ft. to ft. From ft. to ft.								
Gravel Pack Intervals: From <b>10</b> ft. to <b>145</b> ft. From ft. to ft. From ft. to ft.								
5 GROUT MATERIAL: 1 Neat cement 2 Cement grout 3 Bentonite 4 Other								
Grouted Intervals: From <b>0</b> ft. to <b>10</b> ft. From ft. to ft. From ft. to ft.								
What is the nearest source of possible contamination: 1 Septic tank 4 Cess pool 7 Sewage lagoon 10 Fuel storage 14 Abandoned water well 2 Sewer lines 5 Seepage pit 8 Feed yard 11 Fertilizer storage 15 Oil well/Gas well 3 Lateral lines 6 Pit privy 9 Livestock pens 12 Insecticide storage 16 Other (specify below) 13 Watertight sewer lines <b>Center of 1/4 Section N/A</b>								
Direction from well How many feet ? Water Well Disinfected? Yes No <b>X</b>								
Was a chemical/bacteriological sample submitted to Department? Yes No <b>X</b> If yes, date sample was submitted month day year Pump Installed? Yes <b>X</b> No								
If Yes: Pump Manufacturer's name <b>Goulds 3 Stage</b> Model No. <b>12 JHO</b> HP <b>60</b> Part <b>Wind Motor</b>								
Depth of Pump Intake <b>100</b> ft. Pumps Capacity rated at <b>800</b> gal./min.								
Type of pump: 1 Submersible 2 Turbine 3 Jet 4 Centrifugal 5 Reciprocating 6 Other								
6 CONTRACTOR'S OR LANDOWNER'S CERTIFICATION: This water well was 1 constructed, (2) reconstructed, or (3) plugged under my jurisdiction and was completed on <b>September</b> month <b>30</b> day <b>1980</b> year								
and this record is true to the best of my knowledge and belief. Kansas Water Well Contractor's License No. <b>208</b>								
This Water Well Record was completed on <b>October</b> month <b>15</b> day <b>1980</b> year under the business name of <b>Minter Wilson Drilling Co., Inc.</b> by (signature) <i>M. Minter</i>								
7 LOCATE WELL'S LOCATION WITH AN "X" IN SECTION BOX:								
								
ELEVATION:								
Depth(s) Groundwater Encountered 1. ft. 2. ft. 3. ft. 4. ft. (Use a second sheet if needed)								
INSTRUCTIONS: Use typewriter or ball point pen, please press firmly and PRINT clearly. Please fill in blanks, underline or circle the correct answers. Send top three copies to Kansas Department of Health and Environment, Division of Environment, Water Well Contractors, Topeka, KS 66620. Send one to WATER WELL OWNER and retain one for your records.								

OFFICE USE ONLY

T


R

17

60

SEC

1/4 CL 1/4 SW 1/4

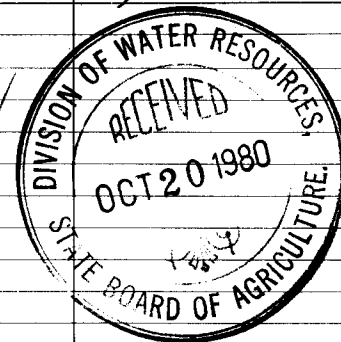

Ref: 11-22-17

**MINTER-WILSON DRILLING CO.**  
INCORPORATED

Commercial  
and Domestic  
Water Systems  
Complete Installation  
and Repairing

Phone 276-5209 • P.O. Box A • GARDEN CITY, KANSAS 67846

**September 4, 1980**

**Robert Lewis  
Pawnee County**

**Location: SW 11-22-17 -  
Static Water Level - 11  
Test # Pivot**

0	1	Top Soil
1	14	Fine Sand
14	65	Brown Clay
65	86	Fine to Med. Sand & Gravel 10% Clay (Loose)
86	95	Brown Clay
95	125	Fine to Med. Sand & Gravel (Loose) with Brown Rock 10% Clay
125	130	Brown Clay
130	142	Fine to Med. Sand & Gravel 10% Clay (Loose)
142	150	Brown Yellow Clay & Shale (Tight)