


1 LOCATION OF WATER WELL: Pawnee
 County: SW 1/4 NE 1/4 NE 1/4 Section Number 33 Township Number T 22 S Range Number R 17 E/W

Distance and direction from nearest town or city street address of well if located within city?
 Approx. 5 1/4 miles scuth and 5 1/4 miles west of Larned

2 WATER WELL OWNER: Leonard Fleske
 RR#, St. Address, Box # : 2401 Dove Board of Agriculture, Division of Water Resources
 City, State, ZIP Code : Great Bend, KS 67530 Application Number: 36,722

3 LOCATE WELL'S LOCATION WITH AN "X" IN SECTION BOX: 4 DEPTH OF COMPLETED WELL: 31 ft. ELEVATION: unknown

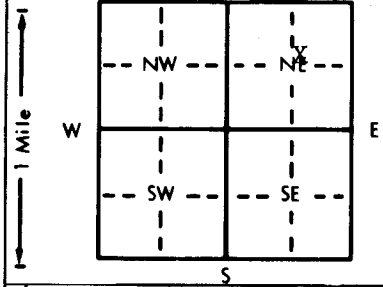

Depth(s) Groundwater Encountered 1. 4 ft. 2. ft. 3. ft.
 WELL'S STATIC WATER LEVEL 4 ft. below land surface measured on mo/day/yr 4-9-84
 Pump test data: Well water was not ck'd. ft. after hours pumping gpm
 Est. Yield 800 ALL 8 WELLS TOGETHER gpm: Well water was ft. after hours pumping gpm
 Bore Hole Diameter 18 in. to 31 ft. and in. to ft.
 WELL WATER TO BE USED AS: 5 Public water supply 8 Air conditioning 11 Injection well
 1 Domestic 3 Feedlot 6 Oil field water supply 9 Dewatering 12 Other (Specify below)
 2 Irrigation 4 Industrial 7 Lawn and garden only 10 Observation well
 Was a chemical/bacteriological sample submitted to Department? Yes No X; If yes, mo/day/yr sample was submitted
 Water Well Disinfected? Yes No X

5 TYPE OF BLANK CASING USED: 5 Wrought iron 8 Concrete tile CASING JOINTS: Glued Clamped
 1 Steel 3 RMP (SR) 6 Asbestos-Cement 9 Other (specify below) Welded XX
 2 PVC 4 ABS 7 Fiberglass Threaded.

Blank casing diameter 8 5/8 in. to 14 ft. Dia 8 5/8 in. to 31 ft. Dia in. to ft.
 Casing height above land surface 12 in., weight 16.90 lbs./ft. Wall thickness or gauge No. 188

TYPE OF SCREEN OR PERFORATION MATERIAL: 7 PVC 10 Asbestos-cement
 1 Steel 3 Stainless steel 5 Fiberglass 8 RMP (SR) 11 Other (specify)
 2 Brass 4 Galvanized steel 6 Concrete tile 9 ABS 12 None used (open hole)

SCREEN OR PERFORATION OPENINGS ARE: 5 Gauzed wrapped 8 Saw cut 11 None (open hole)
 1 Continuous slot 3 Mill slot 6 Wire wrapped 9 Drilled holes
 2 Louvered shutter 4 Key punched 7 Torch cut 10 Other (specify) DOERR BRIDGE SLOT

SCREEN-PERFORATED INTERVALS: From 14 ft. to 22 ft., From ft. to ft.
 GRAVEL PACK INTERVALS: From 10 ft. to 31 ft., From ft. to ft.

6 GROUT MATERIAL: 1 Neat cement 2 Cement grout 3 Bentonite 4 Other
 Grout Intervals: From 0 ft. to 10 ft., From ft. to ft., From ft. to ft.

What is the nearest source of possible contamination:
 1 Septic tank 4 Lateral lines 7 Pit privy 10 Livestock pens 14 Abandoned water well
 2 Sewer lines 5 Cess pool 8 Sewage lagoon 11 Fuel storage 15 Oil well/Gas well
 3 Watertight sewer lines 6 Seepage pit 9 Feedyard 12 Fertilizer storage 16 Other (specify below) FIELD

Direction from well? all around well How many feet?

FROM	TO	LITHOLOGIC LOG	FROM	TO	LITHOLOGIC LOG
0	2	Topsoil			
2	19	Sand & gravel, med. to coarse			
19	22	Very soft sandy clay			
22	31	Brown clay			

7 CONTRACTOR'S OR LANDOWNER'S CERTIFICATION: This water well was (1) constructed, (2) reconstructed, or (3) plugged under my jurisdiction and was completed on (mo/day/year) 4-9-84 and this record is true to the best of my knowledge and belief. Kansas Water Well Contractor's License No. 185 This Water Well Record was completed on (mo/day/yr) 4-19-84 under the business name of Clarke Well & Eq., Inc. by (signature)

INSTRUCTIONS: Use typewriter or ball point pen, PLEASE PRESS FIRMLY and PRINT clearly. Please fill in blanks, underline or circle the correct answers. Send top three copies to Kansas Department of Health and Environment, Division of Environment, Environmental Geology Section, Topeka, KS 66620. Send one to WATER WELL OWNER and retain one for your records.

OFFICE USE ONLY
T
R
EW
SEC.
1/4
1/4
1/4