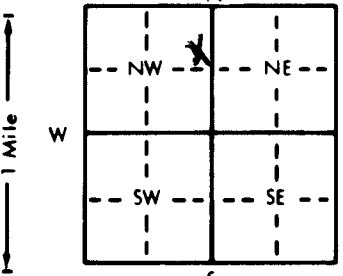


1 LOCATION OF WATER WELL: County: Pawnee		Fraction SE 1/4 NE 1/4 NW 1/4		Section Number 12	Township Number T 22 S	Range Number R 19 E W
Distance and direction from nearest town or city street address of well if located within city? 1 1/2 south, 2 3/4 West of Sanford, Ks.						
2 WATER WELL OWNER: RR#, St. Address, Box # : City, State, ZIP Code :		Kyrle Froetschner Rt. 1 Rozel, Ks. 67574 Board of Agriculture, Division of Water Resources Application Number: 11,001				
3 LOCATE WELL'S LOCATION WITH AN "X" IN SECTION BOX:		4 DEPTH OF COMPLETED WELL 152 ft. ELEVATION: Depth(s) Groundwater Encountered 1. ft. 2. ft. 3. ft. WELL'S STATIC WATER LEVEL 57 ft. below land surface measured on mo/day/yr .. 6-14-95 Pump test data: Well water was 79 ft. after 1 1/2 hours pumping .. 900 gpm Est. Yield 1200 gpm: Well water was 94' 7" ft. after 3 hours pumping ... 1200 ... gpm Bore Hole Diameter 28 in. to 152 ft., and in. to ft. WELL WATER TO BE USED AS: 5 Public water supply 8 Air conditioning 11 Injection well 1 Domestic 3 Feedlot 6 Oil field water supply 9 Dewatering 12 Other (Specify below) 2 Irrigation 4 Industrial 7 Lawn and garden only 10 Monitoring well Was a chemical/bacteriological sample submitted to Department? Yes.....No..... X; If yes, mo/day/yr sample was submitted Water Well Disinfected? Yes No				
						
5 TYPE OF BLANK CASING USED: 1 Steel 3 RMP (SR) 5 Wrought iron 8 Concrete tile CASING JOINTS: Glued X Clamped 2 PVC 4 ABS 6 Asbestos-Cement 9 Other (specify below) Welded 7 Fiberglass Threaded Blank casing diameter 16 in. to 100 ft., Dia in. to ft., Dia in. to ft. Casing height above land surface 12 in., weight SDR 32.5 lbs./ft. Wall thickness or gauge No. TYPE OF SCREEN OR PERFORATION MATERIAL: 7 PVC 10 Asbestos-cement 1 Steel 3 Stainless steel 5 Fiberglass 8 RMP (SR) 11 Other (specify) 2 Brass 4 Galvanized steel 6 Concrete tile 9 ABS 12 None used (open hole) SCREEN OR PERFORATION OPENINGS ARE: 5 Gauzed wrapped 8 Saw cut 11 None (open hole) 1 Continuous slot 3 Mill slot 6 Wire wrapped 9 Drilled holes 2 Louvered shutter 4 Key punched 7 Torch cut 10 Other (specify) SCREEN-PERFORATED INTERVALS: From 100 ft. to 152 ft., From ft. to ft. From ft. to ft., From ft. to ft. GRAVEL PACK INTERVALS: From 152 ft. to 20 ft., From ft. to ft. From ft. to ft., From ft. to ft.						
6 GROUT MATERIAL: 1 Neat cement 2 Cement grout 3 Bentonite 4 Other Grout Intervals: From 20 ft. to 0 ft., From ft. to ft., From ft. to ft. What is the nearest source of possible contamination: 1 Septic tank 4 Lateral lines 7 Pit privy 10 Livestock pens 14 Abandoned water well 2 Sewer lines 5 Cess pool 8 Sewage lagoon 11 Fuel storage 15 Oil well/Gas well 3 Watertight sewer lines 6 Seepage pit 9 Feedyard 12 Fertilizer storage 16 Other (specify below) 13 Insecticide storage none Direction from well? How many feet?						
FROM TO		LITHOLOGIC LOG		FROM TO		PLUGGING INTERVALS
0	3	Top soil				
3	50	Brown & white clay				
50	60	Fine sand little brown clay				
60	67	Sand and gravel Medium				
67	72	Blue clay and sand jmixed				
72	100	Brown, blue, & black clay				
100	112	Sand and gravel clean loose coarse				
112	123	Brown clay				
123	152	Sand and gravel clean coarse loose				
7 CONTRACTOR'S OR LANDOWNER'S CERTIFICATION: This water well was (1) constructed, (2) reconstructed, or (3) plugged under my jurisdiction and was completed on (mo/day/year) 7-5-95 and this record is true to the best of my knowledge and belief. Kansas Water Well Contractor's License No. 134 This Water Well Record was completed on (mo/day/yr) 7-10-95 under the business name of Rosencrantz-Bemis by (signature) Fredia Hedson						
INSTRUCTIONS: Use typewriter or ball point pen. PLEASE PRESS FIRMLY and PRINT clearly. Please fill in blanks, underline or circle the correct answers. Send top three copies to Kansas Department of Health and Environment, Bureau of Water, Topeka, Kansas 66620-0001. Telephone: 913-296-5545. Send one to WATER WELL OWNER and retain one for your records.						

OFFICE USE ONLY

T

R

EW

SEC.

1/4

1/4

1/4