USE TYPEWRITER OR BALL POINT PEN-PRESS FIRMLY, PRINT CLEARLY.

T R EW sec 1/4 1/4 1/4 No.

WATER WELL RECORD
KSA 82a-1201-1215

Kansas State Dept. Of Health
(Water Well Contractors)
Forbes-Bldg. 740
Topeka, Kansas 66620

1 Location of well:	County	Township name	Fraction	Section number	Town number	Range number
	Pawnee	Keysville	CN 1/2 SE 1/4	11	22 S	19 W

Distance and direction from nearest town or city: 2 S. 1 E. 3/4 S.

Street address of well location if in city: 3/4 E. Rozel

3 Owner of well: Geo. Wells c/o John Woelk Rozel, Kans.

Locate with "X" in section below:

Sketch map:

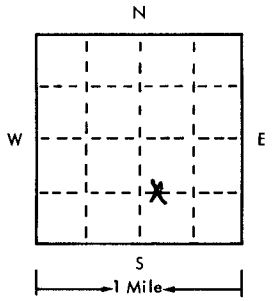

4 Well depth: 150 ft. Date of completion 1-21-75
Well diameter 28 in.

5 ☐ Cable tool ~~☐ Rotary~~ ☐ Driven ☐ Dug
☐ Hollow rod ☐ Jetted ☐ Bored ☒ Reverse rotary

6 Use: ☐ Domestic ☐ Public supply ☐ Industry
☒ Irrigation ☐ Air conditioning ☐ Commercial
☐ Test well ☐ _____

7 Casing: Material BI Height: above/below
Threaded ☐ Welded ☒ Surface 24 in.
Diam. Weight ____ lbs./ft.
16 in. to 90 ft. depth Drive shoe? ☐ Yes ☒ No
____ in. to ____ ft. depth

2

Type and color of material	From	To
Top Soil - Clay	0	42
Sand - Gravel	42	82
Sand	82	150
(use a second sheet if needed)		

8 Screen:
Manufacturer Roeyr
Type ~~Gravel Guard~~ Dia. 16"
Slot/gauze 1/8" Length 80"
Set between ~~40~~ ft. and ~~150~~ ft.
Fittings:
Gravel pack ☒ Yes ☐ No Size range of material 3/8" - 3/4"

9 Static water level:
40 ft. below land surface Date 1-21-75

10 Pumping level below land surfaces:
67 ft. after 2 hrs. pumping 1100 g.p.m.
72 ft. after 3 hrs. pumping 1200 g.p.m.
Estimated maximum yield 1500 g.p.m.

11 Water sample submitted:
☐ Yes ☒ No Date ____

12 Well head completion:
☐ Pitless adapter ☒ Inches above grade 24

13 Well grouted? ☒ Yes ☐ No
☒ Neat cement ☐ Bentonite ☐ _____
Depth: From 0 ft. to 10 ft.

14 Nearest source of possible contamination:
ft. 2640 Direction NW Type Barn Yard
Well disinfected upon completion? ☐ Yes ☒ No

15 Pump: ☒ Not installed
Manufacturer's name _____
Model number ____ HP ____ Volts ____
Length of drop pipe ____ ft. capacity ____ g.m.p.
Type:
☐ Submersible ☐ Turbine
☐ Jet ☐ Reciprocating
☐ Certrifugal ☐ Other

16 Remarks: elevation

Topography:
☐ Hill
☐ Slope
☐ Upland
☒ Valley

17 Water well contractor's certification:
This well was drilled under my jurisdiction and this report is true to the best of my knowledge and belief.
Kelly Water Well Serv 186
Business name License No.
Address R 2 Great Bend
Signed Kelly Price Date 1-25-75
Authorized representative

Forward the white, blue and pink copies to the Kansas State Dept. Of Health.

Form WWC-5

677-H