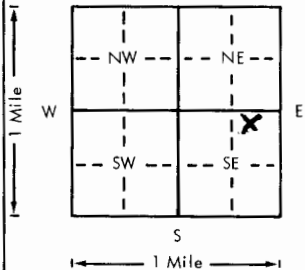
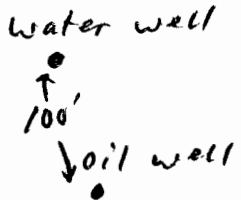


USE TYPEWRITER OR BALL
POINT PEN-PRESS FIRMLY,
PRINT CLEARLY.

WATER WELL RECORD
KSA 82a-1201-1215

Kansas Department of Health and
Environment-Division of Environment
(Water well Contractors)
Topeka, Kansas 66620

1. Location of well:		County Harvey	Fraction N 1/4 NE 1/4 SE 1/4	Section number 4	Township number T 22 S	Range number R 2 E
2. Distance and direction from nearest town or city: 13 E 1 1/2 N Buhler Kan. Street address of well location if in city:			3. Owner of well: Transamerica Oil Corp R.R. or street: 40 Kansas Ave City, state, zip code: South Hutchinson Kan 67505			
4. Locate with "X" in section below:		Sketch map:		6. Bore hole dia. 12 in. Completion date Well depth 61 ft. 9-23-78		
				7. <input type="checkbox"/> Cable tool <input checked="" type="checkbox"/> Rotary <input type="checkbox"/> Driven <input type="checkbox"/> Dug <input type="checkbox"/> Hollow rod <input type="checkbox"/> Jetted <input type="checkbox"/> Bored <input type="checkbox"/> Reverse rotary		
5. Type and color of material		From	To	8. Use: <input type="checkbox"/> Domestic <input type="checkbox"/> Public supply <input type="checkbox"/> Industry <input type="checkbox"/> Irrigation <input type="checkbox"/> Air conditioning <input type="checkbox"/> Stock <input type="checkbox"/> Lawn <input checked="" type="checkbox"/> Oil field water <input type="checkbox"/> Other		
dark brown soil		0	3	9. Casing: Material plastic Height: Above or below Threaded <input type="checkbox"/> Welded <input checked="" type="checkbox"/> Surface 12 in. RMP <input checked="" type="checkbox"/> PVC <input type="checkbox"/> Weight <input type="checkbox"/> lbs./ft. Dia. 6 in. to 61 ft. depth Wall Thickness: inches or Dia. <input type="checkbox"/> in. to <input type="checkbox"/> ft. depth gage No. 1175		
brown clay		3	7	10. Screen: Manufacturer's name JFL Type RMP Dia. 6" Slot/gauze 1/8 hole Length 20 Set between 41 ft. and 61 ft. ft. and <input type="checkbox"/> ft. Gravel pack? yes Size range of material 1/8-1/2"		
sandy clay		7	13	11. Static water level: <input type="checkbox"/> mo./day/yr. 34 ft. below land surface Date 9-23-78		
fine sand		13	16	12. Pumping level below land surfaces: 41 ft. after 1 hrs. pumping 30 g.p.m. <input type="checkbox"/> ft. after <input type="checkbox"/> hrs. pumping <input type="checkbox"/> g.p.m. Estimated maximum yield 75 g.p.m.		
sandy clay		16	28	13. Water sample submitted: <input type="checkbox"/> Yes <input checked="" type="checkbox"/> No Date <input type="checkbox"/> mo./day/yr.		
fine sand		28	33	14. Well head completion: <input type="checkbox"/> Pitless adapter 12 Inches above grade		
fine gravel		33	61	15. Well grouted? yes With: <input type="checkbox"/> Neat cement <input type="checkbox"/> Bentonite <input checked="" type="checkbox"/> Concrete Depth: From 3 ft. to 13 ft.		
				16. Nearest source of possible contamination: ft. 100 Direction SE Type oil well Well disinfected upon completion? <input type="checkbox"/> Yes <input type="checkbox"/> No		
				17. Pump: <input checked="" type="checkbox"/> Not installed Manufacturer's name <input type="checkbox"/> Model number <input type="checkbox"/> HP <input type="checkbox"/> Volts <input type="checkbox"/> Length of drop pipe <input type="checkbox"/> ft. capacity <input type="checkbox"/> g.p.m. Type: <input type="checkbox"/> Submersible <input type="checkbox"/> Turbine <input type="checkbox"/> Jet <input type="checkbox"/> Reciprocating <input type="checkbox"/> Centrifugal <input type="checkbox"/> Other		
				20. Water well contractor's certification: This well was drilled under my jurisdiction and this report is true to the best of my knowledge and belief. Price Water Well 193 Business name RR3 Hutchinson License No. <input type="checkbox"/> Address RR3 Hutchinson Signed J. Davenport Date 6-20-79 Authorized representative		
18. Elevation:		19. Remarks:				
Topography: <input type="checkbox"/> Hill <input checked="" type="checkbox"/> Slope <input checked="" type="checkbox"/> Upland <input type="checkbox"/> Valley		Land owner Myron G. Stucky				