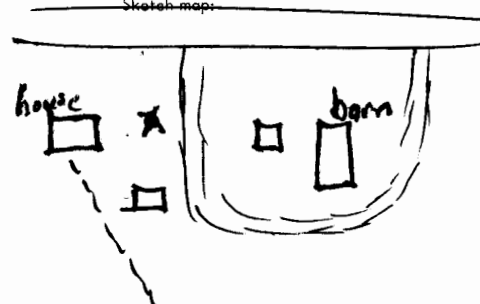


USE TYPEWRITER OR BALL  
POINT PEN-PRESS FIRMLY,  
PRINT CLEARLY.

WATER WELL RECORD  
KSA 82a-1201-1215

Kansas Department of Health and  
Environment-Division of Environment  
(Water well Contractors)  
Topeka, Kansas 66620

|  |  |   |   |  |                                  |   |
|--|--|---|---|--|----------------------------------|---|
| 1. Location of well:                                 |  | County<br><b>HARVEY</b>   | Fraction<br><b>NW 1/4 NE 1/4 NE 1/4</b> | Section number<br><b>11</b>  | Township number<br><b>T 22 S</b> | Range number<br><b>R 2 E</b>  |
| 2. Distance and direction from nearest town or city: |  | 3. Owner of well:   |   | 3. Owner of well:  |                                  |   |
| Street address of well location if in city:          |  | R.R. or street:   |   | R.R. or street:  |                                  |   |
| 4. Locate with "X" in section below:                 |  | Sketch map:   |   | 6. Bore hole dia. <b>11</b> in. Completion date <b>6/6/75</b>  |                                  |   |
| N<br>1 Mile<br>W<br>E<br>S<br>1 Mile                 |  |  |   | Well depth <b>78</b> ft.   |                                  |   |
| 5. Type and color of material                        |  | From  |   | To   |                                  | 7. <input checked="" type="checkbox"/> Cable tool <input checked="" type="checkbox"/> Rotary <input type="checkbox"/> Driven <input type="checkbox"/> Dug                                   |
| <b>LOAM</b>  |  | <b>0</b>  |   | <b>2</b>   |                                  | <input type="checkbox"/> Hollow rod <input type="checkbox"/> Jetted <input type="checkbox"/> Bored <input type="checkbox"/> Reverse rotary  |
| <b>CLAY drk grey</b>                                 |  | <b>2</b>  |   | <b>8</b>   |                                  | 8. Use: <input checked="" type="checkbox"/> Domestic <input type="checkbox"/> Public supply <input type="checkbox"/> Industry   |
| <b>Brown - Red CLAY</b>                              |  | <b>8</b>  |   | <b>15</b>  |                                  | <input type="checkbox"/> Irrigation <input type="checkbox"/> Air conditioning <input type="checkbox"/> Stock  |
| <b>White rock</b>                                    |  | <b>15</b>   |   | <b>17</b>  |                                  | <input type="checkbox"/> Lawn <input type="checkbox"/> Oil field water <input type="checkbox"/> Other   |
| <b>Light grey clay</b>                               |  | <b>17</b>   |   | <b>30</b>  |                                  | 9. Casing: Material <b>plastic</b> Height: <input checked="" type="checkbox"/> Above or below   |
| <b>Soft grey clay</b>                                |  | <b>30</b>   |   | <b>40</b>  |                                  | Threaded <input type="checkbox"/> Welded <input checked="" type="checkbox"/> Surface <b>12</b> in.  |
| <b>grey-brown clay</b>                               |  | <b>40</b>   |   | <b>45</b>  |                                  | RMP <input type="checkbox"/> PVC <input checked="" type="checkbox"/> Weight <b>2.82</b> lbs./ft.  |
| <b>fine Sand</b>                                     |  | <b>45</b>   |   | <b>58</b>  |                                  | Dia. <b>5</b> in. to <b>78</b> ft. depth Wall Thickness: inches or  |
| <b>grey clay</b>                                     |  | <b>58</b>   |   | <b>59</b>  |                                  | Dia. <input type="checkbox"/> in. to <input type="checkbox"/> ft. depth gage No. <b>258</b>   |
| <b>Sandy grey clay</b>                               |  | <b>59</b>   |   | <b>65</b>  |                                  | 10. Screen: Manufacturer's name <b>Pumpco</b>   |
| <b>compacted medium SAND</b>                         |  | <b>65</b>   |   | <b>70</b>  |                                  | Type <b>PVC</b> Dia. <b>5"</b>  |
| <b>SAND clay mix (Nodules)</b>                       |  | <b>70</b>   |   | <b>78</b>  |                                  | Slot/gauze <b>.020</b> Length <b>10'</b>  |
|  |  |   |   |  |                                  | Set between <b>66</b> ft. and <b>76</b> ft.   |
|  |  |   |   |  |                                  | Gravel pack? <input checked="" type="checkbox"/> Size range of material <b>1/8</b>  |
|  |  |   |   |  |                                  | 11. Static water level: <b>31</b> ft. below land surface Date <b>6/25/75</b>  |
|  |  |   |   |  |                                  | 12. Pumping level below land surfaces:  |
|  |  |   |   |  |                                  | <b>47</b> ft. after <b>2</b> hrs. pumping <b>18</b> g.p.m.  |
|  |  |   |   |  |                                  | <b>47</b> ft. after <b>2</b> hrs. pumping <b>18</b> g.p.m.  |
|  |  |   |   |  |                                  | Estimated maximum yield <b>20/30</b> g.p.m.   |
|  |  |   |   |  |                                  | 13. Water sample submitted: <b>Yes</b> <input checked="" type="checkbox"/> <b>No</b> <input type="checkbox"/> Date <b>6/25/75</b>   |
|  |  |   |   |  |                                  | 14. Well head completion: <input checked="" type="checkbox"/> Pitless adapter <b>12</b> inches above grade  |
|  |  |   |   |  |                                  | 15. Well grouted? <input checked="" type="checkbox"/> With: <input checked="" type="checkbox"/> Neat cement <input checked="" type="checkbox"/> Bentonite <input type="checkbox"/> Concrete |
|  |  |   |   |  |                                  | Depth: From <b>0</b> ft. to <b>10</b> ft.   |
|  |  |   |   |  |                                  | 16. Nearest source of possible contamination: <b>Super</b> ft. <b>40'</b> Direction <b>Se.</b> Type <b>Line</b>   |
|  |  |   |   |  |                                  | Well disinfected upon completion? <input checked="" type="checkbox"/> <b>Yes</b> <input type="checkbox"/> <b>No</b>   |
|  |  |   |   |  |                                  | 17. Pump: <input type="checkbox"/> Not installed  |
|  |  |   |   |  |                                  | Manufacturer's name <b>Dempster</b>   |
|  |  |   |   |  |                                  | Model number <b>HBC-3-50-50</b> 1/2 Volts <b>230</b>  |
|  |  |   |   |  |                                  | Length of drop pipe <b>50</b> ft. capacity <b>18</b> g.p.m.   |
|  |  |   |   |  |                                  | Type: <input checked="" type="checkbox"/> Submersible <input type="checkbox"/> Turbine  |
|  |  |   |   |  |                                  | <input type="checkbox"/> Jet <input type="checkbox"/> Reciprocating   |
|  |  |   |   |  |                                  | <input type="checkbox"/> Centrifugal <input type="checkbox"/> Other   |
| 18. Elevation:                                       |  | 19. Remarks:  |   | 20. Water well contractor's certification:   |                                  |   |
| Topography:  |  |   |   | This well was drilled under my jurisdiction and this report is true to the best of my knowledge and belief |                                  |   |
| <input type="checkbox"/> Hill                        |  |   |   | <b>PAULIS TAIL</b> #175  |                                  |   |
| <input type="checkbox"/> Slope                       |  |   |   | Business name <b>Box 26</b> License No. <b>Heaton KS</b>   |                                  |   |
