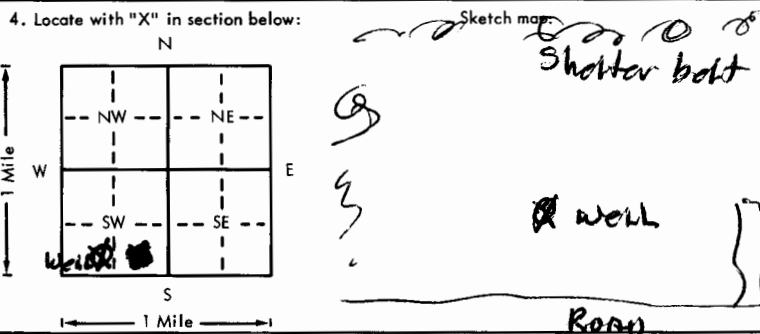


USE TYPEWRITER OR BALL
POINT PEN-PRESS FIRMLY,
PRINT CLEARLY.

WATER WELL RECORD
KSA 82a-1201-1215

Kansas Department of Health and
Environment-Division of Environment
(Water well Contractors)
Topeka, Kansas 66620

1. Location of well:		County HARVEY	Fraction SE 1/4 SW 1/4 SW 1/4	Section number 13	Township number T 22 S R 2 E	Range number 2
2. Distance and direction from nearest town or city: Street address of well location if in city:		4 mile West of Hessston		3. Owner of well: STAN SWARTZEN DRUBER R.R. or street: RR #1 City, state, zip code: HESSSTON, KANS 67062		
4. Locate with "X" in section below: 		6. Bore hole dia. 14 in. Completion date 10/28/77 Well depth 75 ft.				
5. Type and color of material		7. <input checked="" type="checkbox"/> Cable tool <input checked="" type="checkbox"/> Rotary <input type="checkbox"/> Driven <input type="checkbox"/> Dug <input type="checkbox"/> Hollow rod <input type="checkbox"/> Jetted <input type="checkbox"/> Bored <input type="checkbox"/> Reverse rotary				
		8. Use: <input checked="" type="checkbox"/> Domestic <input type="checkbox"/> Public supply <input type="checkbox"/> Industry <input checked="" type="checkbox"/> Irrigation <input type="checkbox"/> Air conditioning <input type="checkbox"/> Stock <input checked="" type="checkbox"/> Lawn <input type="checkbox"/> Oil field water <input type="checkbox"/> Other				
		9. Casing: Material Plastic Height: Above or below Threaded <input type="checkbox"/> Welded <input checked="" type="checkbox"/> Surface 18 in. RMP <input type="checkbox"/> PVC <input checked="" type="checkbox"/> Weight 18 lbs./ft. Dia. 6 in. to 75 ft. depth Wall Thickness: inches or Dia. 6 in. to 75 ft. depth Gage No. 2200				
		10. Screen: Manufacturer's name Western - own sign Type PVC Dia. 6 Slot/gauze 10/46 Length 20' Set between 42 ft. and 62 ft. Gravel pack? <input checked="" type="checkbox"/> Size range of material 1/8-1/4				
		11. Static water level: 31 ft. below land surface Date 10/28/77				
		12. Pumping level below land surfaces: 43 ft. after 2 hrs. pumping 15 g.p.m. ft. after 2 hrs. pumping 15 g.p.m. Estimated maximum yield 20/30 g.p.m.				
		13. Water sample submitted: Yes <input checked="" type="checkbox"/> No <input type="checkbox"/> Date 10/28/77				
		14. Well head completion: <input type="checkbox"/> Pitless adapter <input type="checkbox"/> Inches above grade				
		15. Well grouted? <input checked="" type="checkbox"/> With: <input checked="" type="checkbox"/> Neat cement <input type="checkbox"/> Bentonite <input type="checkbox"/> Concrete Depth: From 0 ft. to 10 ft.				
		16. Nearest source of possible contamination: ft. 50 plus Direction unknown Well disinfected upon completion? <input checked="" type="checkbox"/> Yes <input type="checkbox"/> No				
		17. Pump: <input checked="" type="checkbox"/> Not installed Manufacturer's name Paul's Inc # 175 Model number 175 HP 1/2 Volts 115 Length of drop pipe 75 ft. capacity 15 g.p.m. Type: <input type="checkbox"/> Submersible <input type="checkbox"/> Turbine <input type="checkbox"/> Jet <input type="checkbox"/> Reciprocating <input type="checkbox"/> Centrifugal <input type="checkbox"/> Other				
18. Elevation:		19. Remarks: Homestead to be built in the Future - location & type of disposal system unknown now.				
Topography: <input checked="" type="checkbox"/> Hill <input checked="" type="checkbox"/> Slope <input type="checkbox"/> Upland <input type="checkbox"/> Valley		20. Water well contractor's certification: This well was drilled under my jurisdiction and this report is true to the best of my knowledge and belief. PAUL'S INC # 175 Business name PAUL'S INC License No. 175 Address HESSSTON, KANS Signed Paul Bushart Date 10/28/77 Authorized representative				