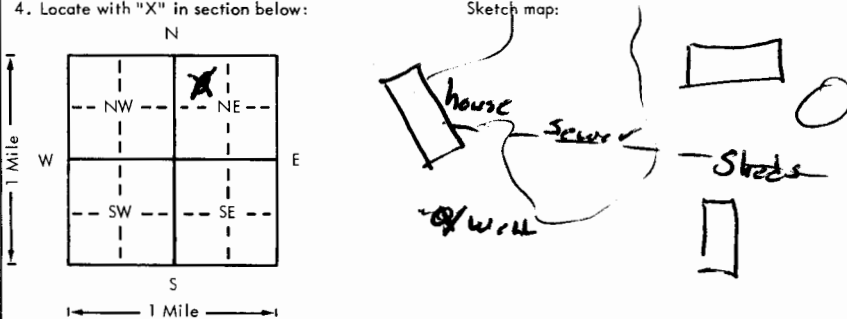


USE TYPEWRITER OR BALL
POINT PEN-PRESS FIRMLY,
PRINT CLEARLY.

WATER WELL RECORD
KSA 82a-1201-1215

Kansas Department of Health and
Environment-Division of Environment
(Water well Contractors)
Topeka, Kansas 66620

1. Location of well:		County HARVEY	Fraction NE 1/4 NW 1/4 NE 1/4	Section number 16	Township number T 22 S R 2 EW	Range number
2. Distance and direction from nearest town or city: Street address of well location if in city:		5 1/4 mile west of HESSTON		3. Owner of well: Robert Schvag R.R. or street: RR #1 City, state, zip code: Moundville, KS		
4. Locate with "X" in section below:		Sketch map:		6. Bore hole dia. 11 in. Completion date 11/1/78 Well depth 63 ft.		
				7. <input checked="" type="checkbox"/> Cable tool <input checked="" type="checkbox"/> Rotary <input type="checkbox"/> Driven <input type="checkbox"/> Dug <input type="checkbox"/> Hollow rod <input type="checkbox"/> Jetted <input type="checkbox"/> Bored <input type="checkbox"/> Reverse rotary		
5. Type and color of material		From		To		8. Use: <input checked="" type="checkbox"/> Domestic <input type="checkbox"/> Public supply <input type="checkbox"/> Industry <input type="checkbox"/> Irrigation <input type="checkbox"/> Air conditioning <input type="checkbox"/> Stock <input type="checkbox"/> Lawn <input type="checkbox"/> Oil field water <input type="checkbox"/> Other
LOAM -		0		3		9. Casing: Material Plastic Height Above or below Threaded <input type="checkbox"/> Welded <input checked="" type="checkbox"/> Surface 12 in. RMP <input type="checkbox"/> PVC <input checked="" type="checkbox"/> Weight 2.87 lbs./ft. Dia. 5 in. to 63 ft. depth Wall Thickness: inches or Dia. <input type="checkbox"/> in. to <input type="checkbox"/> ft. depth Gauge No. 258
LIGHT BROWN CLAY		3		6		10. Screen: Manufacturer's name KAM-TECH Type PVC Dia. 5" Slot/gauze 0.020 Length 10' Set between 45 ft. and 55 ft. ft. and <input type="checkbox"/> ft. Gravel pack? <input checked="" type="checkbox"/> Size range of material 1/8-1/4
RED BROWN CLAY		6		10		11. Static water level: <input type="checkbox"/> mo./day/yr. 23 ft. below land surface Date 11/1/78
LIGHT GREY CLAY		10		17		12. Pumping level below land surfaces: 26 ft. after 2 hrs. pumping 18 g.p.m. ft. after <input type="checkbox"/> hrs. pumping <input type="checkbox"/> g.p.m. Estimated maximum yield 50/60 g.p.m.
FINE BROWN SAND		17		20		13. Water sample submitted: <input type="checkbox"/> Yes <input checked="" type="checkbox"/> No Date <input type="checkbox"/>
LIGHT GREY CLAY - some SAND		20		30		14. Well head completion: <input checked="" type="checkbox"/> Pitless adapter 12 inches above grade
MEDIUM COURSE SAND		30		35		15. Well grouted? <input checked="" type="checkbox"/> With: <input checked="" type="checkbox"/> Neat cement <input checked="" type="checkbox"/> Bentonite <input type="checkbox"/> Concrete Depth: From 0 ft. to 10 ft.
LIGHT GREY CLAY w/ SAND		35		48		16. Nearest source of possible contamination: ft. <input type="checkbox"/> Direction N Type Sewer line Well disinfected upon completion? <input type="checkbox"/> Yes <input type="checkbox"/> No
COURSE SAND		48		55		17. Pump: <input checked="" type="checkbox"/> Not installed Manufacturer's name <input type="checkbox"/> Model number <input type="checkbox"/> HP <input type="checkbox"/> Volts <input type="checkbox"/> Length of drop pipe <input type="checkbox"/> ft. capacity <input type="checkbox"/> g.p.m. Type: <input type="checkbox"/> Submersible <input type="checkbox"/> Turbine <input type="checkbox"/> Jet <input type="checkbox"/> Reciprocating <input type="checkbox"/> Centrifugal <input type="checkbox"/> Other
SANDY BROWN CLAY		55		61		20. Water well contractor's certification: This well was drilled under my jurisdiction and this report is true to the best of my knowledge and belief. PAUL'S INC #175 Business name HESSTON, KS License No. <input type="checkbox"/> Address Paul Burchett Date 11/12/78 Signed Paul Burchett Authorized representative
LIGHT GREY CLAY		61		63		
18. Elevation:		19. Remarks:				
Topography: <input type="checkbox"/> Hill <input type="checkbox"/> Slope <input type="checkbox"/> Upland <input type="checkbox"/> Valley						