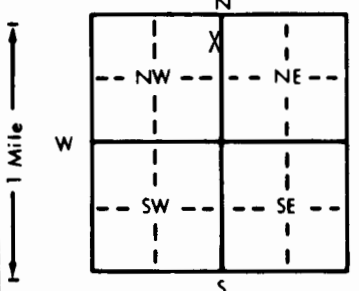


1 LOCATION OF WATER WELL: County: HARVEY		Fraction SE 1/4 NE 1/4 NW 1/4	Section Number 22	Township Number T 22 S	Range Number R 2 E/W
Distance and direction from nearest town or city street address of well if located within city? 5 1/8 MILES SOUTH AND 1/2 MILE WEST OF MOUNDRIDGE, KANSAS					
2 WATER WELL OWNER: LOREN SCHRAG RR#, St. Address, Box # : 12333 NW 72ND City, State, ZIP Code : MOUNDRIDGE, KS 67107 Board of Agriculture, Division of Water Resources Application Number: 4793					
3 LOCATE WELL'S LOCATION WITH AN "X" IN SECTION BOX: 		4 DEPTH OF COMPLETED WELL... 130.5 ft. ELEVATION: Depth(s) Groundwater Encountered 1. ft. 2. ft. 3. ft. WELL'S STATIC WATER LEVEL . . . 4 ft. below land surface measured on mo/day/yr 12/10/93 Pump test data: Well water was ft. after hours pumping gpm Est. Yield gpm Well water was ft. after hours pumping gpm Bore Hole Diameter in. to ft., and in. to ft. WELL WATER TO BE USED AS: 5 Public water supply 8 Air conditioning 11 Injection well 1 Domestic 3 Feedlot 6 Oil field water supply 9 Dewatering 12 Other (Specify below) 2 Irrigation 4 Industrial 7 Lawn and garden only 10 Monitoring well Was a chemical/bacteriological sample submitted to Department? Yes. No. <u>X</u> If yes, mo/day/yr sample was submitted Water Well Disinfected? Yes <u>X</u> No			
5 TYPE OF BLANK CASING USED: 1 Steel 3 RMP (SR) 5 Wrought iron 8 Concrete tile CASING JOINTS: Glued Clamped 2 PVC 4 ABS 6 Asbestos-Cement 9 Other (specify below) Welded 7 Fiberglass Threaded Blank casing diameter 12 in. to ft., Dia in. to ft., Dia in. to ft. Casing height above land surface 38 in., weight lbs./ft. Wall thickness or gauge No. 3/16 INCH TYPE OF SCREEN OR PERFORATION MATERIAL: 1 Steel 3 Stainless steel 5 Fiberglass 8 RMP (SR) 10 Asbestos-cement 11 Other (specify) <u>NA</u> 2 Brass 4 Galvanized steel 6 Concrete tile 9 ABS 12 None used (open hole) SCREEN OR PERFORATION OPENINGS ARE: 1 Continuous slot 3 Mill slot 5 Gauzed wrapped 8 Saw cut 11 None (open hole) 2 Louvered shutter 4 Key punched 6 Wire wrapped 9 Drilled holes 7 Torch cut 10 Other (specify) <u>NA</u> SCREEN-PERFORATED INTERVALS: From <u>NA</u> ft. to <u>NA</u> ft., From ft. to ft. GRAVEL PACK INTERVALS: From ft. to ft., From ft. to ft.					
6 GROUT MATERIAL: 1 Neat cement 2 Cement grout 3 Bentonite 4 Other Grout Intervals: From 10 ft. to 3 ft., From ft. to ft., From ft. to ft. What is the nearest source of possible contamination: 1 Septic tank 4 Lateral lines 7 Pit privy 10 Livestock pens 14 Abandoned water well 2 Sewer lines 5 Cess pool 8 Sewage lagoon 11 Fuel storage 15 Oil well/Gas well 3 Watertight sewer lines 6 Seepage pit 9 Feedyard 12 Fertilizer storage 16 Other (specify below) 13 Insecticide storage Direction from well? NORTHEAST How many feet? APPROXIMATELY 1000					
FROM	TO	LITHOLOGIC LOG	FROM	TO	PLUGGING INTERVALS
			130.5	10	SAND AND GRAVEL
			10	3	BENTONITE HOLEPLUG
			3	0	TOPSOIL
*WELL PLUGGING WITNESSED BY EQUUS BEDS GMD2 PERSONNEL, DON KOCI					
7 CONTRACTOR'S OR LANDOWNER'S CERTIFICATION: This water well was (1) constructed, (2) reconstructed, or (3) plugged under my jurisdiction and was completed on (mo/day/year) 12/10/93 and this record is true to the best of my knowledge and belief. Kansas Water Well Contractor's License No. N/A This Water Well Record was completed on (mo/day/yr) 12-10-93 under the business name of N/A by (signature) Loren Schrag					