

1	LOCATION OF WATER WELL:	Fraction	Section Number	Township Number	Range Number
County:	Harvey	NE ¼ NE ¼ SE ¼	22	T 22 S	R 2 EW

Distance and direction from nearest town or city street address of well if located within city?

5 1/2 mi S of Mundridge - 6507 N Halstead


2 WATER WELL OWNER : Robert Janzen
RR#, St. Address, Box # : 6507 N Halstead
City, State, ZIP Code : Moundville, KS 67107

Board of Agriculture, Division of Water Resources
Application Number:

3 LOCATE WELL'S LOCATION WITH 4 DEPTH OF COMPLETED WELL... 60... ft. ELEVATION:.....

AN "X" IN SECTION BOX:

4 DEPTH OF COMPLETED WELL... 60 ft. ELEVATION:

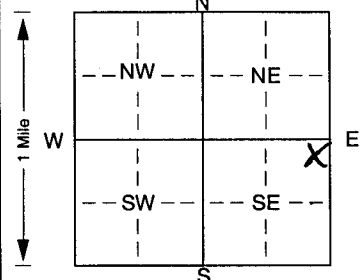

Depth(s) Groundwater Encountered 1. ft. 2. ft. 3. ft.

WELL'S STATIC WATER LEVEL...29.....ft. below land surface measured on mo/day/yr ...1...=22=00.....

Pump test data: Well water was ... 34 ... ft. after ... 2 ... hours pumping ... 2.5 ... gpm

Est. Yieldgpm: Well water wasft. after hours pumping gpm

Bore Hole Diameter. . . 8 in. to 6.1 ft., and in. to ft.

WELL WATER TO BE USED AS: 5 Public water supply 8 Air conditioning 11 Injection well

☒ Domestic 3 Feedlot 6 Oil field water supply 9 Dewatering 12 Other (Specify below)

2 Irrigation 4 Industrial 7 Domestic (lawn & garden) 10 Monitoring well

Was a chemical/bacteriological sample submitted to Department? Yes. No. X ; If yes, mo/day/yr sample was submitted
 Water Well Disinfected? Yes X No

5] TYPE OF BLANK CASING USED:	5 Wrought iron	8 Concrete tile	CASING JOINTS: Glued..... Clamped.....
-------------------------------	----------------	-----------------	--

1 Steel	3 RMP (SR)	6 Asbestos-Cement	9 Other (specify below)	Welded
2 PVC	4 ABS	7 Fiberglass		Threaded

Blank casing diameter 5 in. to 43 ft., Dia 5 in. to 60 ft., Dia in. to ft.

Casing height above land surface. . . . 12. in., weight 2.29. lbs./ft. Wall thickness or gauge No. . . 16.0.

TYPE OF SCREEN OR PERFORATION MATERIAL: 7 PVC 10 Asbestos-cement

1 Steel	3 Stainless steel	5 Fiberglass	8 RMP (SR)	11 Other (specify)
2 Brass	4 Galvanized steel	6 Concrete tile	9 ABS	12 None used (open hole)

SCREEN OR PERFORATION OPENINGS ARE: 5 Gauzed wrapped 8 Saw cut 11 None (open hole)

1 Continuous slot	3 Mill slot	6 Wire wrapped	9 Drilled holes
2 Louvered shutter	4 Key punched	7 Torch cut	10 Other (specify) ft.

SCREEN-PERFORATED INTERVALS: From.....43..... ft. to53..... ft., From ft. to ft.

From..... ft. to ft., From ft. to..... ft.

GRAVEL PACK INTERVALS: From 23 ft. to 67 ft., From _____ ft. to _____ ft.
From _____ ft. to _____ ft., From _____ ft. to _____ ft.

6	GROUT MATERIAL:	1 Neat cement	2 Cement grout	3 Bentonite	4 Other
---	-----------------	---------------	----------------	-------------	---------------

Grout Intervals: From . . . 3 . . . ft. to . . . 23 . . . ft., From ft. to ft., From ft. to ft.

What is the nearest source of possible contamination: 10 Livestock pens 14 Abandoned water well

1 Septic tank	4 Lateral lines	7 Pit privy	11 Fuel storage	15 Oil well/Gas well

2 Sewer lines	5 Cess pool	8 Sewage lagoon	12 Fertilizer storage	16 Other (specify below)
3 Watertight sewer lines	6 Seepage pit	9 Feedyard	13 Insecticide storage	

Direction from well? W How many feet? 100

FROM	TO	LITHOLOGIC LOG	FROM	TO	PLUGGING INTERVALS
------	----	----------------	------	----	--------------------

[illegible]

7 CONTRACTOR'S OR LANDOWNER'S CERTIFICATION: This water well was (1) constructed, (2) reconstructed, or (3) plugged under my jurisdiction and was

completed on (mo/day/year) 1-22-00 and this record is true to the best of my knowledge and belief. Kansas

Water Well Contractor's Licence No. 447 This Water Well Record was completed on (mo/day/yr) 2-15-88
under the business name of Miller Drilling by (signature) E Miller