

1 LOCATION OF WATER WELL: Fraction NE 1/4 NE 1/4 NE 1/4 Section Number 25 Township Number T 22 S Range Number R 2 EW
 County: Harvey

Distance and direction from nearest town or city street address of well if located within city?


2 mi. W, 2 S of Hesston - 5811 N Essex Height Rd

2 WATER WELL OWNER: Weldon Vogt
 RR#, St. Address, Box #: 5811 N Essex Height Rd
 City, State, ZIP Code: Hesston, KS 67062

Board of Agriculture, Division of Water Resources
 Application Number:

3 LOCATE WELL'S LOCATION WITH 4 DEPTH OF COMPLETED WELL: 62 ft. ELEVATION:

AN "X" IN SECTION BOX:

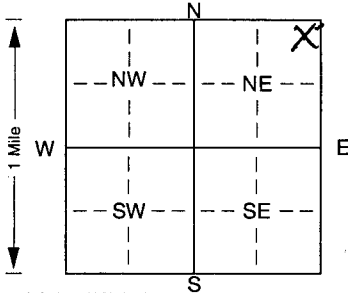

Depth(s) Groundwater Encountered 1. ft. 2. ft. 3. ft.

WELL'S STATIC WATER LEVEL: 10 ft. below land surface measured on mo/day/yr 6-26-01

Pump test data: Well water was 16 ft. after 12 hours pumping 30 gpm

Est. Yield gpm: Well water was ft. after hours pumping gpm

Bore Hole Diameter: 8 in. to 6.4 ft., and in. to ft.

WELL WATER TO BE USED AS: 5 Public water supply 8 Air conditioning 11 Injection well

☒ Domestic 3 Feedlot 6 Oil field water supply 9 Dewatering 12 Other (Specify below)

2 Irrigation 4 Industrial 7 Domestic (lawn & garden) 10 Monitoring well

Was a chemical/bacteriological sample submitted to Department? Yes. No. X; If yes, mo/day/yr sample was submitted
 Water Well Disinfected? Yes X No

5 TYPE OF BLANK CASING USED: 5 Wrought iron 8 Concrete tile CASING JOINTS: Glued. X Clamped.

1 Steel 3 RMP (SR) 6 Asbestos-Cement 9 Other (specify below) Welded

☒ PVC 4 ABS 7 Fiberglass Threaded.

Blank casing diameter 5 in. to 5.2 ft., Dia in. to ft., Dia in. to ft.

Casing height above land surface: 12 in., weight 2.29 lbs./ft. Wall thickness or gauge No. 160

TYPE OF SCREEN OR PERFORATION MATERIAL: ☒ PVC 10 Asbestos-cement

1 Steel 3 Stainless steel 5 Fiberglass 8 RMP (SR) 11 Other (specify)

2 Brass 4 Galvanized steel 6 Concrete tile 9 ABS 12 None used (open hole)

SCREEN OR PERFORATION OPENINGS ARE: 5 Gauzed wrapped ☒ Saw cut 11 None (open hole)

1 Continuous slot 3 Mill slot 6 Wire wrapped 9 Drilled holes

2 Louvered shutter 4 Key punched 7 Torch cut 10 Other (specify) ft.

SCREEN-PERFORATED INTERVALS: From 5.2 ft. to 6.2 ft., From ft. to ft.

From ft. to ft., From ft. to ft.

GRAVEL PACK INTERVALS: From 2.3 ft. to 4.0 ft., From ft. to ft.

From 4.5 ft. to 6.4 ft., From ft. to ft.

6 GROUT MATERIAL: 1 Neat cement 2 Cement grout ☒ Bentonite 4 Other

Grout Intervals: From 3 ft. to 2.3 ft., From 4.0 ft. to 4.5 ft., From ft. to ft.

What is the nearest source of possible contamination: 10 Livestock pens 14 Abandoned water well

☒ Septic tank 4 Lateral lines 7 Pit privy 11 Fuel storage 15 Oil well/Gas well

2 Sewer lines 5 Cess pool 8 Sewage lagoon 12 Fertilizer storage 16 Other (specify below)

3 Watertight sewer lines 6 Seepage pit 9 Feedyard 13 Insecticide storage

Direction from well? S How many feet? 175

FROM TO LITHOLOGIC LOG FROM TO PLUGGING INTERVALS

0 18 Br clay

18 22 clay silt

22 24 F-M sand

24 51 Br + Gr clay

51 64 F-M sand

7 CONTRACTOR'S OR LANDOWNER'S CERTIFICATION: This water well was ☒ constructed, (2) reconstructed, or (3) plugged under my jurisdiction and was completed on (mo/day/year) 6-26-01 and this record is true to the best of my knowledge and belief. Kansas

Water Well Contractor's Licence No. 447 This Water Well Record was completed on (mo/day/yr) 7-7-01

under the business name of Miller Drilling by (signature) E Miller