421 6590 WATER WELL RECORD Form WWC-5 KSA 82a-1212 ID No. OB 7-04

1 LOCATION OF WATER WELL: County: Harvey | Fraction: NE 1/4 NW 1/4 NW 1/4 | Section Number: 25 | Township Number: T 22 S | Range Number: R 2 E (W)

Distance and direction from nearest town or city street address of well if located within city?
Approximately 2 3/4 miles west and 2 miles south of Hesston

2 WATER WELL OWNER: Harvey County RWD #1
RR#, St. Address, Box # : 107 N. Walnut - P.O. Box 124
City, State, ZIP Code : Peabody, KS 66866
Board of Agriculture, Division of Water Resources Application Number:

3 LOCATE WELL'S LOCATION WITH AN "X" IN SECTION BOX:

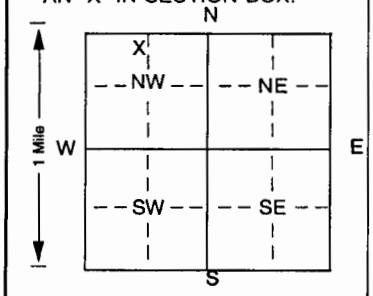

4 DEPTH OF COMPLETED WELL 119 ft. ELEVATION: unknown
Depth(s) Groundwater Encountered 1 ft. 2 ft. 3 . ft.
WELL'S STATIC WATER LEVEL 29.78 ft. below land surface measured on mo/day/yr 8-17-04
Pump test data: Well water was not checked ft. after hours pumping gpm
Est. Yield unknown gpm: Well water was ft. after hours pumping gpm
Bore Hole Diameter 5 in. to 135 ft., and in. to ft.

WELL WATER TO BE USED AS: 5 Public water supply 8 Air conditioning 11 Injection well
1 Domestic 3 Feedlot 6 Oil field water supply 9 Dewatering 12 Other (specify below)
2 Irrigation 4 Industrial 7 Domestic (lawn & garden) 10 Monitoring well Observation Well

Was a chemical/bacteriological sample submitted to Department? Yes No ✓ If yes, mo/day/yrs sample was submitted
Water Well Disinfected? Yes No ✓

5 TYPE OF BLANK CASING USED: 1 Steel 3 RMP (SR) (2) PVC 4 ABS 5 Wrought iron 6 Asbestos-Cement 7 Fiberglass 8 Concrete tile 9 Other (specify below)
CASING JOINTS: Glued ✓ Clamped Welded Threaded

Blank casing diameter 2 in. to 77 ft., Dia in. to ft., Dia in. to ft
Casing height above land surface 24 in., weight .44 lbs./ft. Wall thickness or gauge No .091

TYPE OF SCREEN OR PERFORATION MATERIAL: 1 Steel 2 Brass 3 Stainless steel 4 Galvanized steel 5 Fiberglass 6 Concrete tile (7) PVC 8 RMP (SR) 9 ABS 10 Asbestos-cement 11 Other (specify) 12 None used (open hole)

SCREEN OR PERFORATION OPENINGS ARE: 1 Continuous slot (3) Mill slot 2 Louvered shutter 4 Key punched 5 Gauzed wrapped 6 Wire wrapped 7 Torch cut 8 Saw cut 9 Drilled holes 10 Other (specify) 11 None (open hole)

SCREEN-PERFORATED INTERVALS: From 77 ft. to 117 ft., From ft. to ft.
From ft. to ft., From ft. to ft.
GRAVEL PACK INTERVALS: From 40 ft. to 135 ft., From ft. to ft.
From ft. to ft., From ft. to ft.

6 GROUT MATERIAL: 1 Neat cement 2 Cement grout 3 Bentonite 4 Other Bentonite Holeplug

Grout Intervals: From ft. to ft., From ft. to ft., From 0 ft. to 40 ft.

What is the nearest source of possible contamination:
1 Septic tank 2 Sewer lines 3 Watertight sewer lines 4 Lateral lines 5 Cess pool 6 Seepage pit 7 Pit privy 8 Sewage lagoon 9 Feedyard 10 Livestock pens 11 Fuel storage 12 Fertilizer storage 13 Insecticide storage 14 Abandoned water well 15 Oil well/Gas well 16 Other (specify below) None known

Direction from well? How many feet?

FROM	TO	LITHOLOGIC LOG	FROM	TO	PLUGGING INTERVALS
0	4	Topsoil	105	117	Sand and gravel, coarse to fine
4	7	Clay, brown	117	120	Cemented sand
7	8	Clay, tan	120	126	Clay, tan and cemented sand
8	16	Sand and gravel, medium to fine	126	131	Sand, coarse to fine and clay streaks
16	35	Clay, white	131	135	Shale, gray, limy
35	36	Cemented sand			
36	42	Sand, coarse to fine and gravel, fine			
42	54	Clay, white			
54	55	Sand, very fine			
55	67	Sand, coarse to fine and gravel, fine			
67	74	Clay, tan			
74	81	Sand and gravel, medium to fine and clay streaks			
81	95	Sand and gravel, coarse to fine and clay streaks			
95	105	Clay, tan and sand streaks			

RECEIVED
AUG 26 2004
BUREAU OF WATER

7 CONTRACTOR'S OR LANDOWNER'S CERTIFICATION: This water well was (1) constructed, (2) reconstructed, or (3) plugged under my jurisdiction and was completed on (mo/day/year) 8-17-04 and this record is true to the best of my knowledge and belief. Kansas Water Well Contractor's License No 185 This Water Well Record was completed on (mo/day/yr) 8-24-04 under the business name of Clarke Well & Equipment, Inc. by (signature) Dave W. Clark

INSTRUCTIONS: Use typewriter or ball point pen. *PLEASE PRESS FIRMLY* and *PRINT* clearly. Please fill in blanks, underline or circle the correct answers. Send top three copies to Kansas Department of Health and Environment, Bureau of Water, Topeka, Kansas 66620-0001. Telephone 785-296-5524. Send one to WATER WELL OWNER and retain one for your records. Fee of $5.00 for each constructed well.