

WATER WELL RECORD

Form WWC-5

Division of Water Resources App. No.


Empty box for application number

1 LOCATION OF WATER WELL: County: Pawnee, Fraction: 1/4 NE 1/4 NE 1/4 SE 1/4, Section Number: 16, Township No.: T 22 S, Range Number: R 20, E, W

Street/Rural Address of Well Location; if unknown, distance & direction from nearest town or intersection: If at owner's address, check here []. 3 1/2 South, 1/4 East of Burdett

Global Positioning System (GPS) information: Latitude: 38.13847, Longitude: 099.51624, Elevation: , Datum: [] WGS 84, [x] NAD 83, [] NAD 27, Collection Method: [x] GPS unit, [] Digital Map/Photo, [] Topographic Map, [] Land Survey, Est. Accuracy: [] <3 m, [] 3-5 m, [] 5-15 m, [] >15 m

2 WATER WELL OWNER: Richard Josefiak, RR#, Street Address, Box #: 1345 280th Avenue, City, State, ZIP Code: Rozel, KS 67576

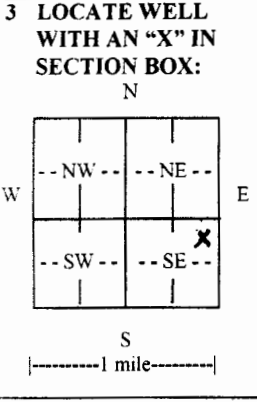

4 DEPTH OF COMPLETED WELL 160 ft. Depth(s) Groundwater Encountered (1)..... ft. (2)..... ft. (3)..... ft. WELL'S STATIC WATER LEVEL 78 ft. below land surface measured on mo/day/yr. 7-22-15. Pump test data: Well water was..... ft. after..... hours pumping..... gpm. EST. YIELD N/A gpm. Well water was..... ft. after..... hours pumping..... gpm. Bore Hole Diameter 10 in. to 160 ft., and..... in. to..... ft. WELL WATER TO BE USED AS: [] Public water supply, [] Geothermal, [] Injection well, [x] Domestic, [] Feedlot, [] Oil field water supply, [] Dewatering, [] Other (Specify below), [] Irrigation, [] Industrial, [] Domestic-lawn & garden, [] Monitoring well. Was a chemical/bacteriological sample submitted to Department? [] Yes, [x] No. If yes, mo/day/yr sample was submitted..... Water well disinfected? [x] Yes, [] No

5 TYPE OF CASING USED: [] Steel, [x] PVC, [] Other. CASING JOINTS: [x] Glued, [] Clamped, [] Welded, [] Threaded. Casing diameter .5 in. to 160 ft., Diameter..... in. to..... ft., Diameter..... in. to..... ft. Casing height above land surface 18 in., Weight SDR-26 lbs./ft., Wall thickness or gauge No. TYPE OF SCREEN OR PERFORATION MATERIAL: [] Steel, [] Stainless Steel, [x] PVC, [] Other (Specify)..... [] Brass, [] Galvanized Steel, [] None used (open hole). SCREEN OR PERFORATION OPENINGS ARE: [] Continuous slot, [] Mill slot, [] Gauze wrapped, [] Torch cut, [] Drilled holes, [] None (open hole), [] Louvered shutter, [] Key punched, [] Wire wrapped, [x] Saw cut, [] Other (specify)..... SCREEN-PERFORATED INTERVALS: From 160 ft. to 140 ft., From..... ft. to..... ft., From..... ft. to..... ft. GRAVEL PACK INTERVALS: From 160 ft. to 20 ft., From..... ft. to..... ft., From..... ft. to..... ft.

6 GROUT MATERIAL: [] Neat cement, [] Cement grout, [x] Bentonite, [] Other. Grout Intervals: From..... ft. to..... ft., From 20 ft. to 0 ft., From..... ft. to..... ft. What is the nearest source of possible contamination: [] Septic tank, [] Lateral lines, [] Pit privy, [] Livestock pens, [] Insecticide storage, [x] Other (specify below), [] Sewer lines, [] Cesspool, [] Sewage lagoon, [] Fuel storage, [] Abandoned water well, [] Watertight sewer lines, [] Seepage pit, [] Feedyard, [] Fertilizer storage, [] Oil well/gas well, House. Direction from well South, Distance from well 400ft.

Table with columns: FROM, TO, LITHOLOGIC LOG, FROM, TO, LITHO. LOG (cont.) or PLUGGING INTERVALS. Rows include: 0-8 Top soil & clay, 8-42 Gray shale, 42-48 Sandstone & shale, 48-71 Gray shale, 71-82 Sandstone & yellow shale, 82-86 Fire clay, 86-100 Lt gray shale w/ sandstone streaks, 100-109 Fire clay, 109-114 Sandstone & shale, 114-144 Fire clay.

7 CONTRACTOR'S OR LANDOWNER'S CERTIFICATION: This water well was [x] constructed, [] reconstructed, or [] plugged under my jurisdiction and was completed on (mo/day/year) 7-24-15 and this record is true to the best of my knowledge and belief. Kansas Water Well Contractor's License No. 134. This Water Well Record was completed on (mo/day/year) 8-5-15 under the business name of Rosencrantz Bemis Ent Inc by (signature) Don Albert

INSTRUCTIONS: Use typewriter or ball point pen. PLEASE PRESS FIRMLY and PRINT clearly. Please fill in blanks and check the correct answers. Send one copy to Kansas Department of Health and Environment, Bureau of Water, Geology Section, 1000 SW Jackson St., Suite 420, Topeka, Kansas 66612-1367. Telephone 785-296-5524. Send one copy to WATER WELL OWNER and retain one for your records. Include fee of \$5.00 for each constructed well. Visit us at