

WATER WELL RECORD

Form WWC-5


Division of Water Resources App. No.

6153

1 LOCATION OF WATER WELL: County: Hodgeman Fraction 1/4 NE 1/4 SE 1/4 SW 1/4 Street/Rural Address of Well Location: 1/2 South, 1/2 West of Gray

Section Number 8 Township No. T 22 S Range Number R 21 Global Positioning System (GPS) information: Latitude: Longitude: Elevation: Datum: Collection Method: Est. Accuracy:

2 WATER WELL OWNER: Norbert/Darlene Burkhart Trusts RR#, Street Address, Box #: 41020 SE Q Road City, State, ZIP Code: Hanston, KS 67849

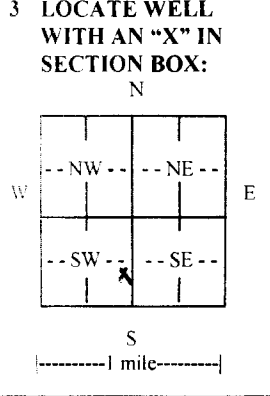

3 LOCATE WELL WITH AN 'X' IN SECTION BOX: 4 DEPTH OF COMPLETED WELL 92 ft. Depth(s) Groundwater Encountered (1) 43 ft. (2) 65 ft. (3) 207 ft. WELL'S STATIC WATER LEVEL 43 ft. below land surface measured on mo/day/yr. 4-2-15 Pump test data: Well water was 65 ft. after 3 hours pumping 207 gpm EST. YIELD 225 gpm. Well water was 67 ft. after 3 1/2 hours pumping 225 gpm Bore Hole Diameter 26 in. to 92 ft. and in. to ft. WELL WATER TO BE USED AS: Irrigation, Domestic, Feedlot, Oil field water supply, Dewatering, Other (Specify below) Was a chemical/bacteriological sample submitted to Department? Yes No If yes, mo/day/yr sample was submitted. Water well disinfected? Yes No

5 TYPE OF CASING USED: Steel PVC Other CASING JOINTS: Glued Clamped Welded Threaded Casing diameter 16 in. to 92 ft., Diameter in. to ft., Diameter in. to ft. Casing height above land surface 18 in., Weight Sch 40 lbs./ft., Wall thickness or gauge No. TYPE OF SCREEN OR PERFORATION MATERIAL: Steel Stainless Steel PVC Other (Specify) Brass Galvanized Steel None used (open hole) SCREEN OR PERFORATION OPENINGS ARE: Continuous slot Mill slot Gauze wrapped Torch cut Drilled holes None (open hole) Louvered shutter Key punched Wire wrapped Saw cut Other (specify) SCREEN-PERFORATED INTERVALS: From 92 ft. to 67 ft., From ft. to ft., From ft. to ft. GRAVEL PACK INTERVALS: From 92 ft. to 20 ft., From ft. to ft., From ft. to ft.

6 GROUT MATERIAL: Neat cement Cement grout Bentonite Other Grout Intervals: From ft. to ft., From 20 ft. to 0 ft., From ft. to ft. What is the nearest source of possible contamination: Septic tank Lateral lines Pit privy Livestock pens Insecticide storage Other (specify below) Sewer lines Cesspool Sewage lagoon Fuel storage Abandoned water well None Watertight sewer lines Seepage pit Feedyard Fertilizer storage Oil well/gas well None Direction from well Distance from well

Table with columns: FROM, TO, LITHOLOGIC LOG, FROM, TO, LITHO. LOG (cont.) or PLUGGING INTERVALS. Rows include: 0-3 Top soil, 3-35 Brown clay, 35-51 Sand & gravel- small to med, 51-55 Gray clay, 55-60 Sand & gravel- med w/ broken rock, 60-64 Gray clay, 64-72 Sand & gravel- med w/ broken rock, 72-83 Sandstone, 83-92 Fire clay.

7 CONTRACTOR'S OR LANDOWNER'S CERTIFICATION: This water well was constructed, reconstructed, or plugged under my jurisdiction and was completed on (mo/day/year) 5-30-15 and this record is true to the best of my knowledge and belief. Kansas Water Well Contractor's License No. 134 This Water Well Record was completed on (mo/day/year) 6-15-15 under the business name of Rosencrantz- Bemis Ent Inc by (signature) [Signature]

INSTRUCTIONS: Use typewriter or ball point pen. PLEASE PRESS FIRMLY and PRINT clearly. Please fill in blanks and check the correct answers. Send one copy to Kansas Department of Health and Environment, Bureau of Water, Geology Section, 1000 SW Jackson St., Suite 420, Topeka, Kansas 66612-1367. Telephone 785-296-5524. Send one copy to WATER WELL OWNER and retain one for your records. Include fee of \$5.00 for each constructed well. Visit us at http://www.kdheks.gov/waterwell/index.html