


WATER WELL RECORD Form WWC-5 KSA 82a-1212

1 LOCATION OF WATER WELL: Fraction NW 1/4 SW 1/4 NE 1/4 Section Number 8 Township Number T 22 S Range Number R 21 W  
 COUNTY: HODGEMAN

Distance and direction from nearest town or city street address of well if located within city?

2 WATER WELL OWNER: PARR, GORDAN K. TRUST Board of Agriculture, Division of Water Resources  
 RR#, St. Address, Box #: ROUTE 1 -- BOX 37 Application Number: 6595  
 City, State, ZIP code: HANSTON, KS 67849-

3 LOCATE WELL'S LOCATION WITH AN "X" IN SECTION BOX: 4 DEPTH OF COMPLETED WELL 100 ELEVATION: 0  
 Depth(s) Groundwater Encountered 1. 0 ft. 2. 0 ft. 3. 0 ft.

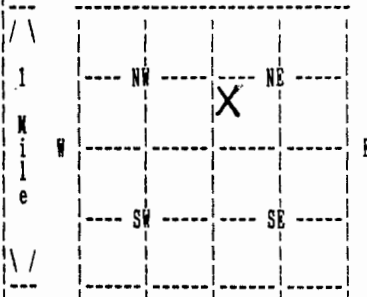

WELL'S STATIC WATER LEVEL 0 ft. below land surface measured on no/day/yr  
 Pump test data: Well water was 0 ft. after 0 hours pumping 0 gpm

Estimated Yield 0 gpm: Well water was 0 ft. after 0 hours pumping 0 gpm

Bore Hole Diameter 26 in. to 100 ft., and in. to 0 ft.

WELL WATER TO BE USED AS: IRRIGATION

Was a chemical/bacteriological sample submitted to department? No ;  
 If yes, no/day/yr sample was submitted Water well disinfected? Yes

5 TYPE OF BLANK CASING USED: PVC CASING JOINTS: GLUED  
 Blank casing diameter 16 in. to 100 ft., Dia in. to 0 ft., Dia in. to 0 ft.  
 Casing height above land surface 18 in., weight 0 lbs/ft. Wall thickness or gauge No. 40  
 TYPE OF SCREEN OR PERFORATION MATERIAL: PVC  
 SCREEN OR PERFORATION OPENINGS ARE: SAW CUT

SCREEN PERFORATED INTERVALS: From 55 ft. to 85 ft., From 0 ft. to 0 ft.  
 From 0 ft. to 0 ft., From 0 ft. to 0 ft.  
 GRAVEL PACK INTERVALS: From 22 ft. to 100 ft., From 0 ft. to 0 ft.  
 From 0 ft. to 0 ft., From 0 ft. to 0 ft.

6 GROUT MATERIAL BENTONITE  
 Grout Intervals: From 5 ft. to 22 ft., From 0 ft. to 0 ft., From 0 ft. to 0 ft.  
 What is the nearest source of possible contamination: ABANDONED WELL  
 Direction from well? NORTH How many feet? 150

FROM	TO	LITHOLOGIC LOG	FROM	TO	PLUGGING INTERVALS
0	40	TOPSOIL GRAY CLAY			
40	82	MED-COARSE SAND FINE SAND			
82	100	GRAY SHALE RED BED			

7 CONTRACTOR'S OR LANDOWNER'S CERTIFICATION: This water well was Constructed under my jurisdiction and was completed on (no/day/year) 11/16/94 and this record is true to the best of my knowledge and belief. Kansas Water Well Contractor's License No. 179 This Water Well Record was completed on (no/day/yr) 12/08/94 under the business name of JOB'S WELL SERVICE, INC. by (signature) *Josiah Cwik*