


1 LOCATION OF WATER WELL: Fraction NW 1/4 SW 1/4 NW 1/4 Section Number 2 Township Number T 22 S Range Number R 22 E/W  
 County: HODGEMAN

Distance and direction from nearest town or city street address of well if located within city? 3 mile North of Hanston Ks.

2 WATER WELL OWNER: TONY MANN RT 1 BOX 49 Board of Agriculture, Division of Water Resources  
 RR#, St. Address, Box # HANSTON KS 67849 Application Number:  
 City, State, ZIP Code

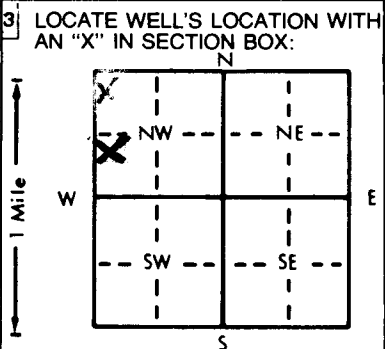

4 DEPTH OF COMPLETED WELL... 218 ft. ELEVATION: UPLAND  
 Depth(s) Groundwater Encountered 1. 208 ft. 2. .... ft. 3. .... ft.  
 WELL'S STATIC WATER LEVEL 85.5 ft. below land surface measured on mo/day/yr AUGUST 8, 1991  
 Pump test data: Well water was 148 ft. after 40 hours pumping 12 gpm  
 Est. Yield 40 gpm: Well water was .... ft. after .... hours pumping .... gpm  
 Bore Hole Diameter... 8.5 in. to 20 ft., and 8 in. to 218 ft.  
 WELL WATER TO BE USED AS:  
 1 Domestic 3 Feedlot 6 Oil field water supply 9 Dewatering 12 Other (Specify below)  
 2 Irrigation 4 Industrial 7 Lawn and garden only 10 Monitoring well  
 Was a chemical/bacteriological sample submitted to Department? Yes.....No. XX; If yes, mo/day/yr sample was submitted  
 Water Well Disinfected? Yes XX No

5 TYPE OF BLANK CASING USED:  
 1 Steel 3 RMP (SR) 5 Wrought iron 8 Concrete tile CASING JOINTS: Glued XX Clamped  
2 PVC 4 ABS 6 Asbestos-Cement 9 Other (specify below) Welded  
 7 Fiberglass Threaded  
 Blank casing diameter 5 in. to 189 ft., Dia. .... in. to .... ft., Dia. .... in. to .... ft.  
 Casing height above land surface 12 in., weight 2.87 lbs./ft. Wall thickness or gauge No. 265"  
 TYPE OF SCREEN OR PERFORATION MATERIAL:  
 1 Steel 3 Stainless steel 5 Fiberglass 7 PVC 8 RMP (SR) 10 Asbestos-cement 11 Other (specify)  
 2 Brass 4 Galvanized steel 6 Concrete tile 9 ABS 12 None used (open hole)  
 SCREEN OR PERFORATION OPENINGS ARE:  
 1 Continuous slot 3 Mill slot 5 Gauzed wrapped 8 Saw cut 11 None (open hole)  
 2 Louvered shutter 4 Key punched 6 Wire wrapped 9 Drilled holes  
 7 Torch cut 10 Other (specify)  
 SCREEN-PERFORATED INTERVALS: From 198 ft. to 218 ft., From .... ft. to .... ft.  
 From .... ft. to .... ft., From .... ft. to .... ft.  
 GRAVEL PACK INTERVALS: From 69 ft. to 218 ft., From .... ft. to .... ft.  
 From 25 ft. to 58 ft., From .... ft. to .... ft.

6 GROUT MATERIAL: 1 Neat cement 5 2 Cement grout 25 3 Bentonite 58 4 Other 69  
 Grout Intervals: From .... ft. to .... ft., From .... ft. to .... ft., From .... ft. to .... ft.  
 What is the nearest source of possible contamination:  
 1 Septic tank 4 Lateral lines 7 Pit privy 10 Livestock pens 14 Abandoned water well  
 2 Sewer lines 5 Cess pool 8 Sewage lagoon 11 Fuel storage 15 Oil well/Gas well  
 3 Watertight sewer lines 6 Seepage pit 9 Feedyard 12 Fertilizer storage 16 Other (specify below)  
 13 Insecticide storage  
 Direction from well? WEST How many feet? 100

FROM	TO	LITHOLOGIC LOG	FROM	TO	PLUGGING INTERVALS
0	2	black topsoil			
2	10	tan clay			
10	12	fine sand			
12	19	brown clay			
19	33	sand & gravel			
33	34	srtip of rock			
34	45	soft tan clay			
45	48	strip of sand			
48	50	mixed clay			
50	85	rainbow clay			
85	91	red clay			
91	208	multi-colored shale or clay			
208	213	sandstone			
213	220	multi-colored shale or clay			

7 CONTRACTOR'S OR LANDOWNER'S CERTIFICATION: This water well was (1) constructed, (2) reconstructed, or (3) plugged under my jurisdiction and was completed on (mo/day/year) AUGUST 08, 1991 and this record is true to the best of my knowledge and belief. Kansas Water Well Contractor's License No. 243 This Water Well Record was completed on (mo/day/yr) AUGUST 26, 1991 under the business name of DEAN WATERHOUSE DRILLING by (signature) Dean Waterhouse