


MW-5

1 LOCATION OF WATER WELL: County: Hodgeman Fraction: SW 1/4 NW 1/4 SW 1/4 Section Number: 23 Township Number: T 22 S Range Number: R 22 EW

Distance and direction from nearest town or city street address of well if located within city? NE corner of Main & Logan, Hanston

2 WATER WELL OWNER: RR#, St. Address, Box #: Jim Winget Box 169 Hanston KS 67849 Board of Agriculture, Division of Water Resources Application Number:

3 LOCATE WELL'S LOCATION WITH AN "X" IN SECTION BOX:

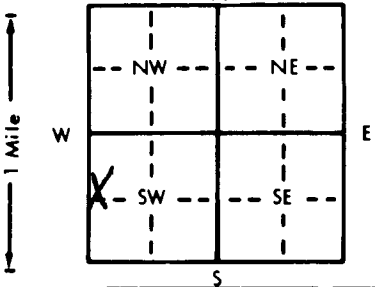

4 DEPTH OF COMPLETED WELL: 41.0 ft. ELEVATION: NA

Depth(s) Groundwater Encountered 1. NA ft. 2. ft. 3. ft. WELL'S STATIC WATER LEVEL 36.82 ft. below land surface measured on mo/day/yr 12/14/92

Pump test data: Well water was ft. after hours pumping gpm Est. Yield gpm Well water was ft. after hours pumping gpm Bore Hole Diameter 8 in. to ft., and in. to ft.

WELL WATER TO BE USED AS: 5 Public water supply 8 Air conditioning 11 Injection well 1 Domestic 3 Feedlot 6 Oil field water supply 9 Dewatering 12 Other (Specify below) 2 Irrigation 4 Industrial 7 Lawn and garden only 10 Monitoring well

Was a chemical/bacteriological sample submitted to Department? Yes No X; If yes, mo/day/yr sample was submitted Water Well Disinfected? Yes No X

5 TYPE OF BLANK CASING USED: 1 Steel 3 RMP (SR) 5 Wrought iron 8 Concrete tile CASING JOINTS: Glued Clamped

2 PVC 4 ABS 6 Asbestos-Cement 9 Other (specify below) Welded Threaded Flush

Blank casing diameter 2 in. to ft. Dia. in. to ft. Dia. in. to ft. Casing height above land surface Flush in. weight 703 lbs./ft. Wall thickness or gauge No. .154

TYPE OF SCREEN OR PERFORATION MATERIAL: 1 Steel 3 Stainless steel 5 Fiberglass 8 RMP (SR) 10 Asbestos-cement 11 Other (specify)

2 Brass 4 Galvanized steel 6 Concrete tile 9 ABS 12 None used (open hole) SCREEN OR PERFORATION OPENINGS ARE: 5 Gauzed wrapped 8 Saw cut 11 None (open hole)

1 Continuous slot 3 Mill slot 6 Wire wrapped 9 Drilled holes 10 Other (specify)

2 Louvered shutter 4 Key punched 7 Torch cut SCREEN-PERFORATED INTERVALS: From 26.0 ft. to 41.0 ft. From ft. to ft. From ft. to ft.

GRAVEL PACK INTERVALS: From 25.0 ft. to 41.0 ft. From ft. to ft. From ft. to ft.

6 GROUT MATERIAL: 1 Neat cement 2 Cement grout 3 Bentonite 4 Other Grout Intervals: From 25.0 ft. to 1.0 ft. From ft. to ft. From ft. to ft.

What is the nearest source of possible contamination: 1 Septic tank 4 Lateral lines 7 Pit privy 11 Fuel storage 14 Abandoned water well

2 Sewer lines 5 Cess pool 8 Sewage lagoon 12 Fertilizer storage 15 Oil well/Gas well 3 Watertight sewer lines 6 Seepage pit 9 Feedyard 13 Insecticide storage 16 Other (specify below)

Direction from well? West How many feet? 50

FROM	TO	LITHOLOGIC LOG	FROM	TO	PLUGGING INTERVALS
0.0	10.0	Silty Shale, slightly silty			
10.0	30.0	Silty Shale			
30.0	35.0	Very silty shale to			
35.0	41.0	very silty sand			

Flush Mount Waiver granted on 10-22-92 for KHE No. 01042269; Winget Service, by Don Taylor

7 CONTRACTOR'S OR LANDOWNER'S CERTIFICATION: This water well was (1) constructed, (2) reconstructed, or (3) plugged under my jurisdiction and was completed on (mo/day/year) 12/2/92 and this record is true to the best of my knowledge and belief. Kansas

Water Well Contractor's License No. 531 This Water Well Record was completed on (mo/day/yr) 12/8/92 under the business name of GSI by (signature) Allison Irwin