


LOCATION OF WATER WELL: Fraction NE 1/4 NE 1/4 SE 1/4 Section Number 20 Township Number T 22 S Range Number R 22 W  
 COUNTY: HODGEMAN

Distance and direction from nearest town or city street address of well if located within city?  
 FROM HANSTON - 1 1/2 WEST ON COUNTY ROAD

2 WATER WELL OWNER: HOLMES, ROGER Board of Agriculture, Division of Water Resources  
 Rm, St. Address, Box #: P.O. BOX 35 Application Number:  
 City, State, ZIP code: HANSTON, KS 67849-

3 LOCATE WELL'S LOCATION WITH AN "X" IN SECTION BOX:

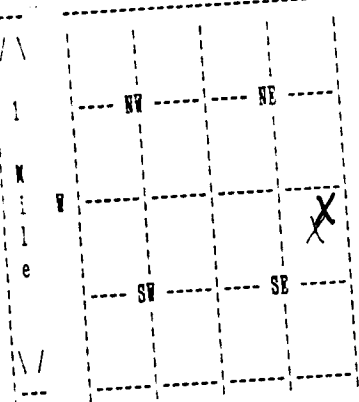

4 DEPTH OF COMPLETED WELL 305 ELEVATION: 0  
 Depth(s) Groundwater Encountered 1. 0 ft. 2. 0 ft. 3. 0 ft.

WELL'S STATIC WATER LEVEL 92 ft. below land surface measured on no/day/yr 05/31/01  
 Pump testdata: Well water was 0 ft. after 0 hours pumping 0 gpm

Estimated Yield 50 gpm: Well water was 0 ft. after 0 hours pumping 0 gpm

Bore Hole Diameter 10 in. to 305 ft., and in. to 0 ft.

WELL WATER TO BE USED AS: DOMESTIC

Was a chemical/bacteriological sample submitted to department? No;  
 If yes, no/day/yr sample was submitted Water well disinfected? Yes

5 TYPE OF BLANK CASING USED: PVC CASING JOINTS: GLUED  
 Blank casing diameter 5 in. to 305 ft., Dia in. to 0 ft., Dia in. to 0 ft.  
 Casing height above land surface 12 in., weight 200 lbs/ft. Wall thickness or gauge No. 21  
 TYPE OF SCREEN OR PERFORATION MATERIAL: PVC  
 SCREEN OR PERFORATION OPENINGS ARE: SAW CUT

SCREEN PERFORATED INTERVALS: From 240 ft. to 300 ft., From 0 ft. to 0 ft.  
 From 0 ft. to 0 ft., From 0 ft. to 0 ft.  
 GRAVEL PACK INTERVALS: From 30 ft. to 305 ft., From 0 ft. to 0 ft.  
 From 0 ft. to 0 ft., From 0 ft. to 0 ft.

6 GROUT MATERIAL BENTONITE  
 Grout Intervals: From 5 ft. to 30 ft., From 0 ft. to 0 ft., From 0 ft. to 0 ft.  
 What is the nearest source of possible contamination: NONE - NEW SITE  
 Direction from well? How many feet? 0

FROM	TO	LITHOLOGIC LOG	FROM	TO	PLUGGING INTERVALS
0	20	01 TOPSOIL 05 CLAY			
20	40	05 CLAY 27 ROCK			
40	60	27 ROCK 16 GRAY CLAY			
60	115	05 CLAY 36 BLUE CLAY			
115	120	29 SANDSTONE			
120	140	26 RED CLAY 16 GRAY CLAY			
140	180	16 GRAY CLAY			
180	220	29 SANDSTONE 16 GRAY CLAY			
220	260	29 SANDSTONE			
260	280	29 SANDSTONE 08 ROCK LAYERS			

7 CONTRACTOR'S OR LANDOWNER'S CERTIFICATION: This water well was Constructed under my jurisdiction and was completed on (no/day/year) 06/01/01 and this record is true to the best of my knowledge and belief. Kansas Water Well Contractor's License No. 179 This Water Well Record was completed on (no/day/yr) 06/07/01 under the business name of JOB'S WELL SERVICE, INC. by (signature) *Juaid Cuck*

*Juaid Cuck*

(Continued)

WATER WELL RECORD Form WWC-5 KSA 82a-1212

1 LOCATION OF WATER WELL:      Fraction      Section Number      Township Number      Range Number  
COUNTY: HODGEMAN      NE 1/4 NE 1/4 SE 1/4      20      T 22 S      R 22 W

2 WATER WELL OWNER:      HOLMES, ROGER  
RR#, St. Address, Box #: P.O. BOX 35      Board of Agriculture, Division of Water Resources  
City, State, ZIP code : HANSTON, KS 67849-      Application Number:

FROM	TO	LITHOLOGIC LOG
280	300	29 SANDSTONE 08 ROCK LAYERS 16 GRAY CLAY
300	380	16 GRAY CLAY 08 ROCK LAYERS

7 CONTRACTOR'S OR LANDOWNER'S CERTIFICATION: This water well was Constructed under my jurisdiction and was completed on (mo/day/year) 06/01/01 and this record is true to the best of my knowledge and belief. Kansas Water Well Contractor's License No. 179      This Water Well Record was completed on (mo/day/yr) 06/07/01 under the business name of JOB'S WELL SERVICE, INC.      by (signature)