


1 LOCATION OF WATER WELL: Fraction Section Number Township Number Range Number
 COUNTY: HOOGENAN NE 1/4 NE 1/4 NE 1/4 3 T 22 S R 22 **W**

Distance and direction from nearest town or city street address of well if located within city?
 FROM HANSTON - 2 1/2 MILES NORTH ON RD. 228

2 WATER WELL OWNER: HOLMES BROS. - & ROGER
 RR#, St. Address, Box #: 35990 NE O RD. Board of Agriculture, Division of Water Resources
 City, State, ZIP code: HANSTON, KS 67849- Application Number:

3 LOCATE WELL'S LOCATION WITH AN "X" IN SECTION BOX: 4 DEPTH OF COMPLETED WELL 285 ELEVATION: 2193
 Depth(s) Groundwater Encountered 1. 0 ft. 2. 0 ft. 3. 0 ft.

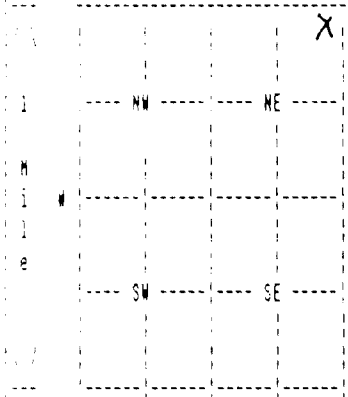

WELL'S STATIC WATER LEVEL 84 ft. below land surface measured on mo/day/yr 03/24/11
 Pump test data: Well water was 0 ft. after 0 hours pumping 0 gpm
 Estimated Yield 40 gpm: Well water was 0 ft. after 0 hours pumping 0 gpm
 Bore Hole Diameter 10 in. to 285 ft., and in. to 0 ft.
 WELL WATER TO BE USED AS: DOMESTIC
 Was a chemical/bacteriological sample submitted to department? No ;
 If yes, mo/day/yr sample was submitted Water well disinfected? Yes

5 TYPE OF BLANK CASING USED: CERTA LOC CASIN CASING JOINTS: CERTA-LOC
 Blank casing diameter 5 in. to 285 ft., Dia in. to 0 ft., Dia in. to 0 ft.
 Casing height above land surface 12 in., weight 200 lbs/ft. Wall thickness or gauge No. 21
 TYPE OF SCREEN OR PERFORATION MATERIAL: PVC
 SCREEN OR PERFORATION OPENINGS ARE: SAW CUT

SCREEN PERFORATED INTERVALS: From 160 ft. to 240 ft., From 0 ft. to 0 ft.
 From 260 ft. to 280 ft., From 0 ft. to 0 ft.
 GRAVEL PACK INTERVALS: From 30 ft. to 285 ft., From 0 ft. to 0 ft.
 From 0 ft. to 0 ft., From 0 ft. to 0 ft.

6 GROUT MATERIAL BENTONITE
 Grout intervals: From 6 ft. to 30 ft., From 0 ft. to 0 ft., From 0 ft. to 0 ft.
 What is the nearest source of possible contamination: NONE
 Direction from well? How many feet? 0

FROM	TO	LITHOLOGIC LOG	FROM	TO	PLUGGING INTERVALS
0	20	01 TOPSOIL 32 TAN CLAY			
20	40	32 TAN CLAY 37 FIN-COAR SAW			
40	60	10 FINE-MEDSAND 32 TAN CLAY			
60	80	32 TAN CLAY 16 GRAY CLAY			
80	160	16 GRAY CLAY 11 BROWN CLAY			
160	240	29 SANDSTONE			
240	260	16 GRAY CLAY			
260	280	29 SANDSTONE 05 CLAY			
280	300	16 GRAY CLAY 08 ROCK LAYERS			

7 CONTRACTOR'S OR LANDOWNER'S CERTIFICATION: This water well was constructed under my jurisdiction and was completed on (mo/day/year) 03/25/11 and this record is true to the best of my knowledge and belief. Kansas Water Well Contractor's License No. 179 This Water Well Record was completed on (mo/day/yr) 03/31/11 under the business name of JOE'S WELL SERVICE, INC. by (signature) *Judith Creek*