

**WATER WELL PLUGGING RECORD Form WWC-5P KSA 82a-1212 ID NO.**

MW1

<b>1 LOCATION OF WATER WELL:</b> County: HODGEMAN	Fraction SE ¼ NW¼ SW ¼ ¼	Section Number 23	Township Number T 22 S	Range Number 22 <input type="checkbox"/> E <input checked="" type="checkbox"/> W
--	-----------------------------	----------------------	---------------------------	---

Street/Rural Address of Well Location; if unknown, distance & direction from nearest town or intersection: If at owner's address, check here

**Global Positioning Systems (GPS) information:**  
 Latitude: 38.1215079 (in decimal degrees)  
 Longitude: -99.7121713 (in decimal degrees)  
 Elevation: \_\_\_\_\_  
 Horizontal Datum:  WGS84,  NAD83,  NAD27  
 Collection Method: \_\_\_\_\_

**2 WATER WELL OWNER:** DODGE CITY COOP HANSTO  
 RR#, St. Address, Box #: 106 N. BROADWAY  
 City, State ZIP Code: HANSTON, KS

GPS unit (Make/Model: \_\_\_\_\_)  
 Digital Map/Photo,  Topographic Map,  Land Survey  
 Est. Accuracy:  < 3 m,  3-5 m,  5-15 m,  > 15 m

**3 MARK WELL'S LOCATION WITH AN "X" IN SECTION BOX:**

N			
	NW		NE
W	x		E
	SW		SE
S			

**4 DEPTH OF WELL** 34.58 ft.  
 WELL'S STATIC WATER LEVEL 29.70 ft  
 WELL WAS USED AS:  
 Domestic  Public Water Supply  Dewatering  
 Irrigation  Oil Field Water Supply  Monitoring  
 Feedlot  Domestic (Lawn & Garden)  Injection Well  
 Industrial  Air Conditioning  Other \_\_\_\_\_  
 Was a chemical/bacteriological sample submitted to Department? Yes  No

**5 TYPE OF BLANK CASING USED:**

Steel  RMP (SR)  Wrought  Fiberglass  Other (Specify below)  
 PVC  ABS  Asbestos-Cement  Concrete Tile

Blank casing diameter 2 in. Was casing pulled? Yes  No  If yes, how much 3'  
 Casing height above or below land surface 0 in.

**6 GROUT PLUG MATERIAL:**  Neat cement  Cement grout  Bentonite  Other GRAVEL


Grout Plug Intervals: From 0 ft. to .5 ft., From .5 ft. to 34.58 ft., From \_\_\_\_\_ ft. to \_\_\_\_\_ ft.

What is the nearest source of possible contamination:  
 Septic tank  Seepage pit  Fuel storage  Other (specify below)  
 Sewer lines  Pit privy  Fertilizer storage  
 Watertight sewer lines  Sewage lagoon  Insecticide storage  
 Lateral lines  Feedyard  Abandoned water well Direction from well? \_\_\_\_\_  
 Cess pool  Livestock pens  Oil well/Gas well How many feet? \_\_\_\_\_

FROM	TO	PLUGGING MATERIALS	FROM	TO	PLUGGING MATERIALS
0	.5	GRAVEL			
.5	34.58	BENTONITE			

**7 CONTRACTOR'S OR LANDOWNER'S CERTIFICATION:** This water well was plugged under my jurisdiction and was completed on (mo/day/year) 4/18/18 and this record is true to the best of my knowledge and belief. Kansas Water Well Contractor's License No. 585. This Water Well Record was completed on (mo/day/year) 5/16/18 under the business name of ASSOCIATED ENVIRONMENTAL INC by (signature) *[Signature]*

Send one white copy to Kansas Department of Health & Environment, Geology Section, 1000 SW Jackson Street, Ste. 420, Topeka, KS 66612-1367. Send one copy to WATER WELL OWNER and retain one for your records.  
 Visit us at <http://www.kdheks.gov/waterwell/index.html> Telephone 785-296-5524.

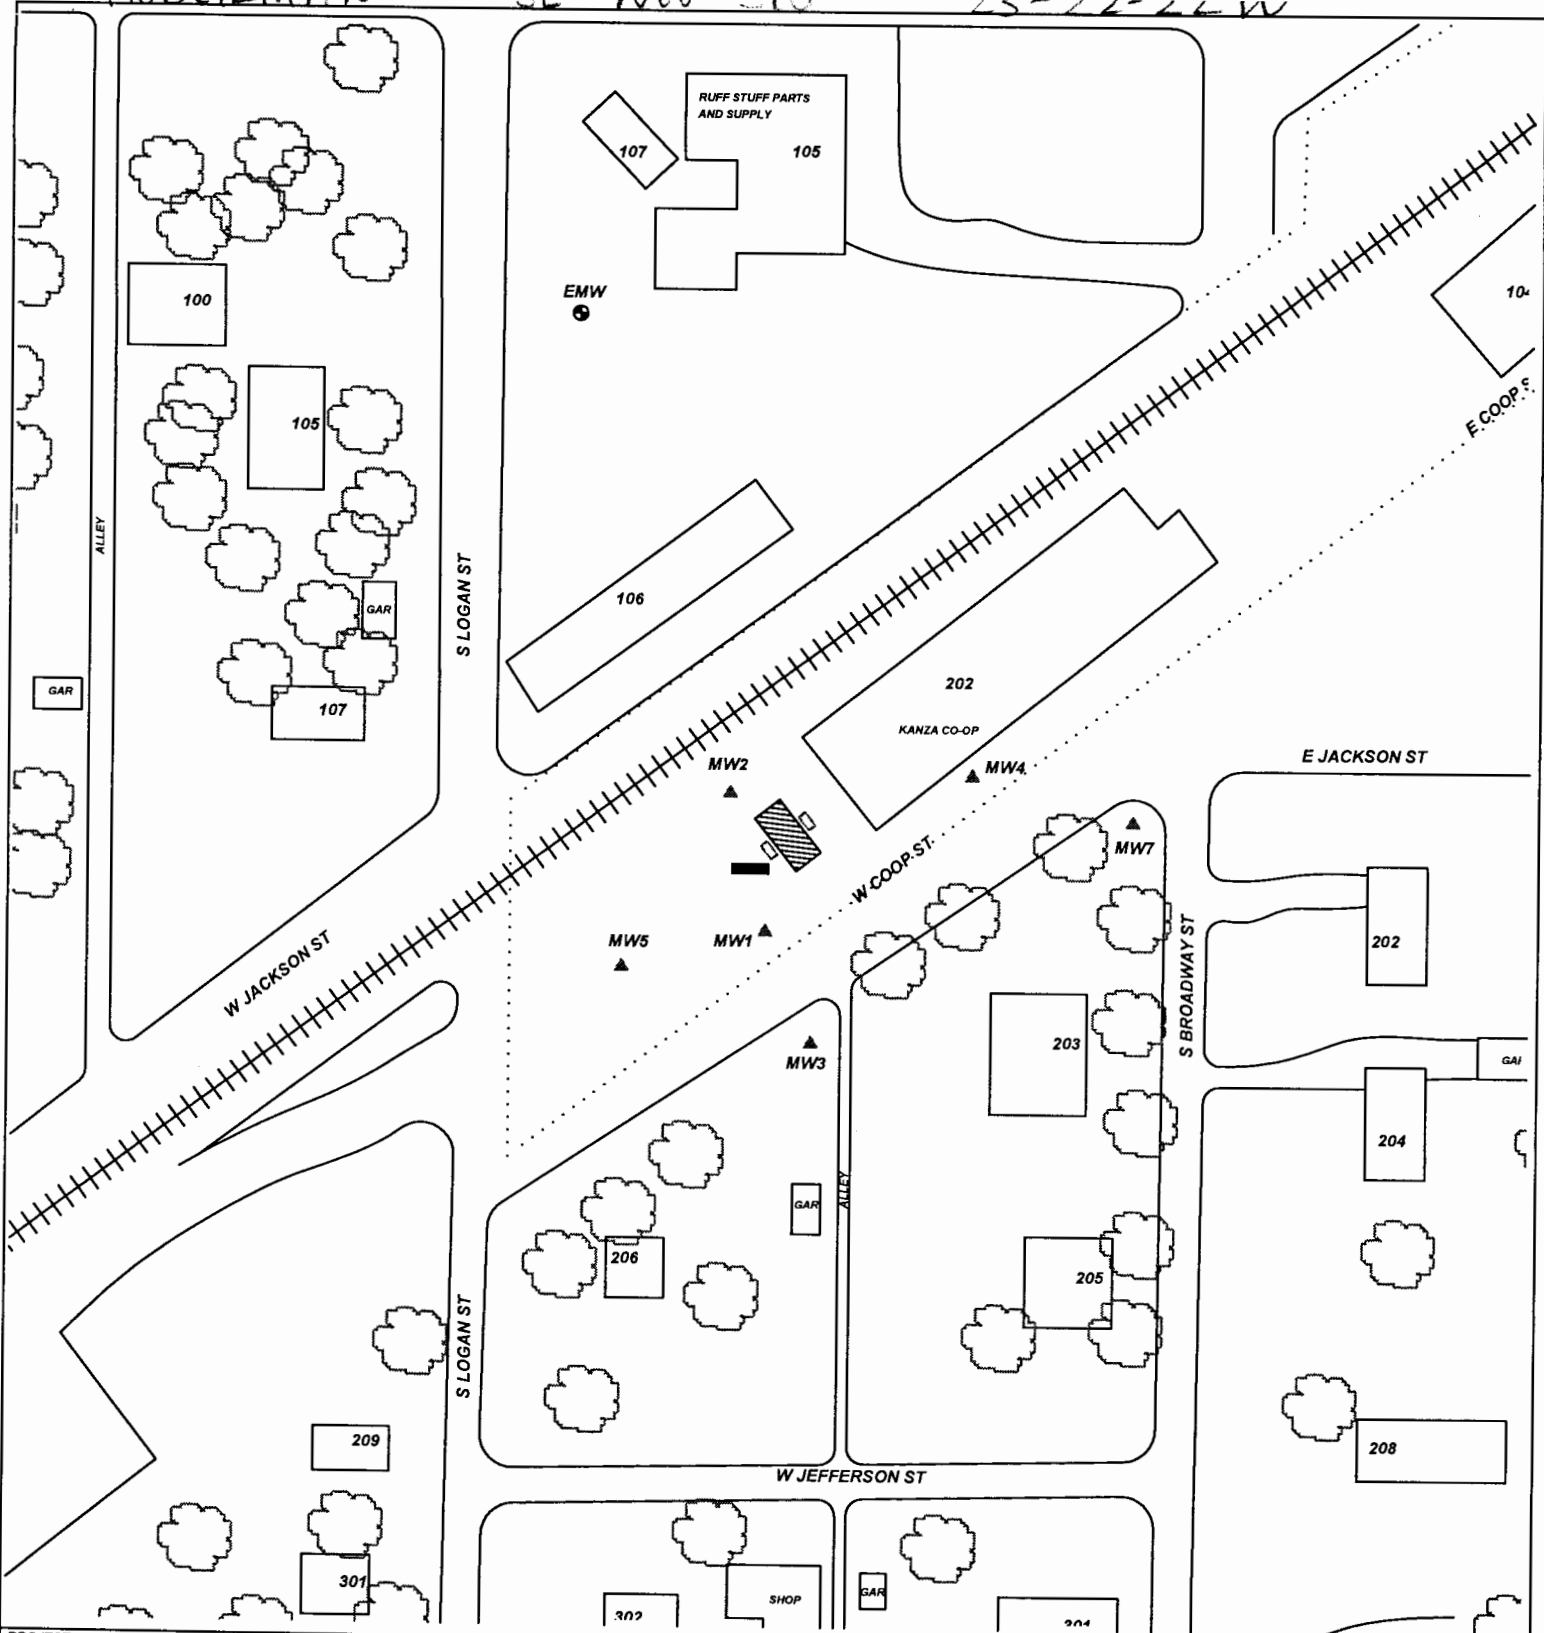

PROJECT: **DODGE CITY COOPERATIVE, INC**

ADDRESS: **106 N BROADWAY**


LOCATION: **HANSTON, KS**

DRAWN BY: **B. STALNAKER** DATE: **6/1/17**


REVISED BY: \_\_\_\_\_ DATE: \_\_\_\_\_

AED JOB # **TF349** KDHE JOB # **U1-042-11832**

SCALE: **1" = 100'**

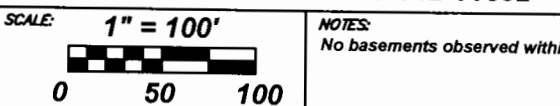

TITLE: \_\_\_\_\_

 

**ASSOCIATED ENVIRONMENTAL INC.**

- LEGEND:**
- = UST BASIN AND FORMER PUMP ISLAND LOCATION. 1- 6000 GAS & 2- 6000 GAL DIESEL REMOVED. 1-6000 GAS & 1- 6000,4000,2000 GAL DIESEL UST'S REMAIN
  - = CURRENT PUMP ISLAND
  - = MONITOR WELL
  - = SUBJECT PROPERTY

NOTES:  
No basements observed within 500'.