

JIMMOKI NE

T R EW sec 1/4 1/4 1/4 No.

USE TYPEWRITER OR BALL POINT PEN-PRESS FIRMLY, PRINT CLEARLY.

WATER WELL RECORD
KSA 82a-1201-1215


Kansas State Dept. Of Health
(Water Well Contractors)
Forbes-Bldg. 740
Topeka, Kansas 66620

ACA

1 Location of well: County HOPGENAN Township name CENTER Fraction NE SW NE Section number 13 Town number 22 Range number 23

Distance and direction from nearest town or city: NE
1N + 4W HANSTON
Street address of well location if in city:

3 Owner of well: B. J. BARRON
CHILDREN TRUST
Address: HANSTON, KS

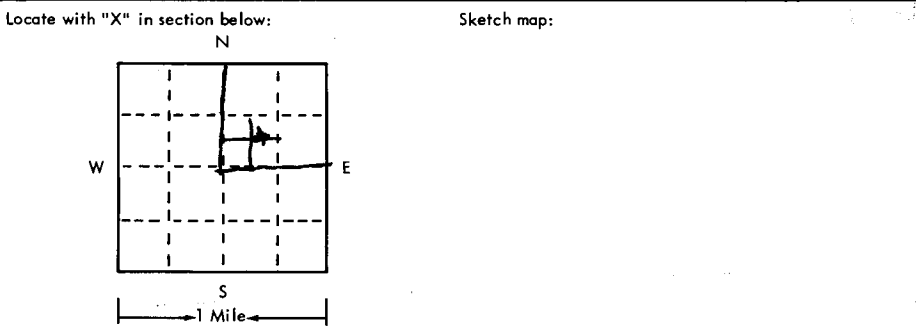

4 Well depth: 190 ft. Date of completion: 2 Dec
Well diameter 5 in.

5 Cable tool Rotary Driven Dug
 Hollow rod Jetted Bored Reverse rotary

6 Use: Domestic Public supply Industry
 Irrigation Air conditioning Commercial
 Test well

7 Casing: Material STYRAC Height above below
Threaded Welded Surface 24 in.
Diam. 250 Weight MAK
+ 9 in. to 120 ft. depth Drive shoe? Yes No
9 in. to 190 ft. depth

2	Type and color of material	From	To
	TOPSOIL	0	6
	CLECHIE + LIMESTONE		
	ROCKY LAYERS	6	20
	HARD ROCK + SHALE	20	38
	BLACK SHALE	38	100
	SHELL ROCK + BLACK SHALE	100	120
	GREY SHALE WITH WHITE STRIPS	120	140
	RED CLAY	140	175
	COURSE SANDSTONE	175	190
	RED CLAY	190	24
	BROCK 6'		
	CRETACEOUS WELL		

8 Screen: Manufacturer J+L
Type STYRENE Dia. _____
Slot/gauze _____ Length _____
Set between 170 ft. and 190 ft. _____
Fittings: _____
Gravel pack Yes No Size range of material 4 dm

9 Static water level: 140 ft. below land surface Date 2-Dec 75

10 Pumping level below land surface: 3 ft. after _____ hrs. pumping _____ g.p.m.
15 ft. after _____ hrs. pumping _____ g.p.m.
Estimated maximum yield 90 g.p.m.

11 Water sample submitted: Yes No Date _____

12 Well head completion: Pitless adapter 24 inches above grade

13 Well grouted? Yes No
 Neat cement Bentonite _____
Depth: From 0 ft. to 9 ft.

14 Nearest source of possible contamination: 15 ft. Direction SE Type TANK
Well disinfected upon completion? Yes No

15 Pump: Not installed
Manufacturer's name _____
Model number _____ HP _____ Volts _____
Length of drop pipe _____ ft. capacity _____ g.m.p.
Type: Submersible Turbine
 Jet Reciprocating
 Centrifugal Other

16 Remarks: elevation 2292
6
2286

Topography: Hill Slope Upland Valley TOPO

17 Water well contractor's certification:
This well was drilled under my jurisdiction and this report is true to the best of my knowledge and belief.
DEAN WATERHOUSE DRILLING
Business name License No. 243
Address HANSTON KANSAS
Signed Dean Waterhouse date 11-Dec 75
Authorized representative

22 23 W 13 NE SW NE