


WATER WELL RECORD Form WWC-5 KSA 82a-1212

1 LOCATION OF WATER WELL: Fraction Section Number Township Number Range Number
 COUNTY: HODGEMAN SE 1/4 NE 1/4 NE 1/4 19 T 22 S R 23 W

Distance and direction from nearest town or city street address of well if located within city?
 FROM JETMORE - HIGHWAY 283 & 156 1 M EAST AND 2 1/2 NORTH

2 WATER WELL OWNER: CRAGHEAD, HARRY Board of Agriculture, Division of Water Resources
 RR#, St. Address, Box #: Application Number:
 City, State, ZIP code : JETMORE, KS 67856-

3 LOCATE WELL'S LOCATION WITH AN "X" IN SECTION BOX:

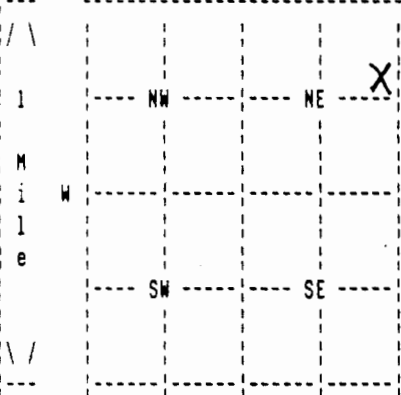

4 DEPTH OF COMPLETED WELL 525 ELEVATION: 0
 Depth(s) Groundwater Encountered 1. 0 ft. 2. 0 ft. 3. 0 ft.

WELL'S STATIC WATER LEVEL 268 ft. below land surface measured on mo/day/yr 10/11/99
 Pump test data: Well water was 0 ft. after 0 hours pumping 0 gpm

Estimated Yield 25 gpm: Well water was 0 ft. after 0 hours pumping 0 gpm

Bore Hole Diameter 9 in. to 525 ft., and in. to 0 ft.

WELL WATER TO BE USED AS: DOMESTIC

Was a chemical/bacteriological sample submitted to department? No ;
 If yes, mo/day/yr sample was submitted Water well disinfected? Yes

5 TYPE OF BLANK CASING USED: PVC CASING JOINTS: GLUED
 Blank casing diameter 5 in. to 525 ft., Dia in. to 0 ft., Dia in. to 0 ft.
 Casing height above land surface 12 in., weight 200 lbs/ft. Wall thickness or gauge No. 21 17
 TYPE OF SCREEN OR PERFORATION MATERIAL: PVC
 SCREEN OR PERFORATION OPENINGS ARE: SAW CUT

SCREEN PERFORATED INTERVALS: From 460 ft. to 520 ft., From 0 ft. to 0 ft.
 From 0 ft. to 0 ft., From 0 ft. to 0 ft.
 GRAVEL PACK INTERVALS: From 0 ft. to 52 ft., From 0 ft. to 0 ft.
 From 120 ft. to 525 ft., From 0 ft. to 0 ft.

6 GROUT MATERIAL BENTONITE
 Grout Intervals: From 52 ft. to 120 ft., From 0 ft. to 0 ft., From 0 ft. to 0 ft.
 What is the nearest source of possible contamination: ABANDONED WELL
 Direction from well? NORTHEAST How many feet? 40

| FROM | TO | LITHOLOGIC LOG | FROM | TO | PLUGGING INTERVALS |
|------|-----|--|------|----|--------------------|
| 0 | 20 | 01 TOPSOIL 05 CLAY 32 TAN IN COLOR | | | |
| 20 | 40 | 05 CLAY 02 FINE SAND 07 BLUE SHALE | | | |
| 40 | 240 | 07 BLUE SHALE 08 ROCK LAYERS | | | |
| 240 | 260 | 07 BLUE SHALE 05 CLAY | | | |
| 260 | 300 | 05 CLAY 32 TAN IN COLOR 12 SAND ROCK LAYER | | | |
| 300 | 330 | 29 SANDSTONE | | | |
| 330 | 410 | 26 RED CLAY 16 GRAY CLAY | | | |
| 410 | 520 | 29 SANDSTONE | | | |
| 520 | 540 | 08 ROCK LAYERS 26 RED CLAY 16 GRAY CLAY | | | |

7 CONTRACTOR'S OR LANDOWNER'S CERTIFICATION: This water well was constructed under my jurisdiction and was completed on (mo/day/year) 10/13/99 and this record is true to the best of my knowledge and belief. Kansas Water Well Contractor's License No. 179 This Water Well Record was completed on (mo/day/yr) 11/11/99 under the business name of JOE'S WELL SERVICE, INC. by (signature) *Justin Crick*