


WATER WELL RECORD Form WWC-5 KSA 82a-1212

1 LOCATION OF WATER WELL: Fraction NE 1/4 NE 1/4 NW 1/4 Section Number 26 Township Number T 22 S Range Number R 23 W
 COUNTY: HODGEMAN

Distance and direction from nearest town or city street address of well if located within city?
 FROM HANSTON - 3 1/2 WEST ON CEMETERY ROAD

2 WATER WELL OWNER: WASKO, PAUL
 GRF. St. Address, Box #: 407 S. BROADWAY Board of Agriculture, Division of Water Resources
 City, State, ZIP code: HANSTON, KS 67849- Application Number:

3 LOCATE WELL'S LOCATION WITH AN "X" IN SECTION BOX: 4 DEPTH OF COMPLETED WELL 265 ELEVATION: 0
 Depth(s) Groundwater Encountered 1. 0 ft. 2. 0 ft. 3. 0 ft.

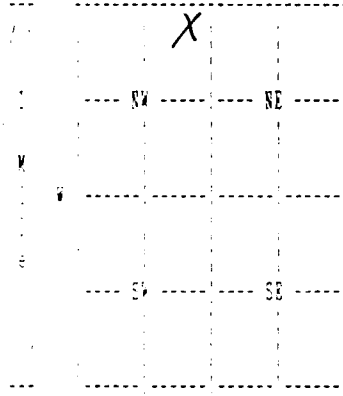

WELL'S STATIC WATER LEVEL 128 ft. below land surface measured on mo/day/yr 11/02/00
 Pump test data: Well water was 0 ft. after 0 hours pumping 0 gpm

Estimated Yield 30 gpm: Well water was 0 ft. after 0 hours pumping 0 gpm

5 Bore Hole Diameter 9 in. to 265 ft., and in. to 0 ft.

WELL WATER TO BE USED AS: DOMESTIC

Was a chemical/bacteriological sample submitted to department? No;
 If yes, mo/day/yr sample was submitted Water well disinfected? Yes

6 TYPE OF BLANK CASING USED: PVC CASING JOINTS: GLUED
 Blank casing diameter 5 in. to 265 ft., Dia in. to 0 ft., Dia in. to 0 ft.
 Casing height above land surface 12 in., weight 200 lbs/ft. Wall thickness or gauge No. 21
 TYPE OF SCREEN OR PERFORATION MATERIAL: PVC
 SCREEN OR PERFORATION OPENINGS ARE: SAW CUT

SCREEN PERFORATED INTERVALS: From 220 ft. to 260 ft., From 0 ft. to 0 ft.
 From 0 ft. to 0 ft., From 0 ft. to 0 ft.
 TRAVEL PACK INTERVALS: From 20 ft. to 265 ft., From 0 ft. to 0 ft.
 From 0 ft. to 0 ft., From 0 ft. to 0 ft.

7 CEMENT MATERIAL BENTONITE
 Casing intervals: From 0 ft. to 20 ft., From 0 ft. to 0 ft., From 0 ft. to 0 ft.
 What is the nearest source of possible contamination: NONE - NEW SITE
 Direction from well: How many feet? 0

FROM	TO	LITHOLOGIC LOG	FROM	TO	PLOGGING INTERVALS
0	30	01 TOPSOIL 05 CLAY 21 LIMESTONE			
30	40	16 GRAY CLAY 07 BLUE SHALE			
40	130	07 BLUE SHALE			
130	160	36 BLUE CLAY			
160	180	16 GRAY CLAY 29 SANDSTONE 19 LAYERS			
180	260	29 SANDSTONE			
260	280	29 SANDSTONE 16 GRAY CLAY			

7 CONTRACTOR'S OR LANDOWNER'S CERTIFICATION: This water well was constructed under my jurisdiction and was completed on (mo/day/year) 11/03/00 and this record is true to the best of my knowledge and belief. Kansas Water Well Contractor's License No. 179 This Water Well Record was completed on (mo/day/yr) 11/14/00 under the business name of JOB'S WELL SERVICE, INC. by (signature) *Judith Crist*