


WATER WELL RECORD Form WWC-5 KSA 82a-1212

1 LOCATION OF WATER WELL: Fraction Section Number Township Number Range Number
 COUNTY: HODGEMAN NW 1/4 SE 1/4 SE 1/4 35 T 22 S R 23 RW

Distance and direction from nearest town or city street address of well if located within city?
 FROM HANSTON - 2 MILES SOUTH & 3/4 MILE EAST

2 WATER WELL OWNER: SIMPSON, TOMMY
 RE#, St. Address, Box #: 2254 STARFIELD PL. Board of Agriculture, Division of Water Resources
 City, State, ZIP code: HOT SPRINGS, AR 71913- Application Number:

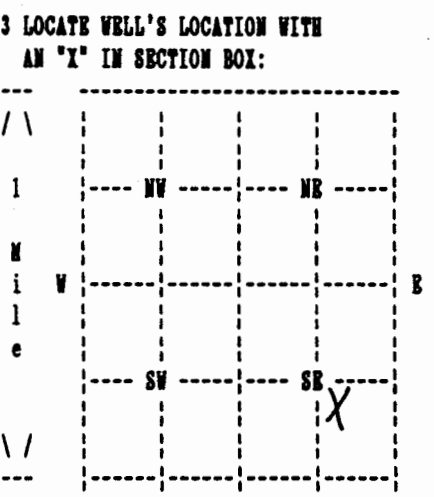

4 DEPTH OF COMPLETED WELL 525 ELEVATION: 0
 Depth(s) Groundwater Encountered 1. 0 ft. 2. 0 ft. 3. 0 ft.
 WELL'S STATIC WATER LEVEL 118 ft. below land surface measured on mo/day/yr 04/05/06
 Pump testdata: Well water was 0 ft. after 0 hours pumping 0 gpm
 Estimated Yield 30 gpm: Well water was 0 ft. after 0 hours pumping 0 gpm
 Bore Hole Diameter 10 in. to 525 ft., and in. to 0 ft.
 WELL WATER TO BE USED AS: DOMESTIC
 Was a chemical/bacteriological sample submitted to department? No ;
 If yes, no/day/yr sample was submitted Water well disinfected? Yes

5 TYPE OF BLANK CASING USED: CERTA LOC CASIN CASING JOINTS: CERTA-LOC
 Blank casing diameter 5 in. to 525 ft., Dia in. to 0 ft., Dia in. to 0 ft.
 Casing height above land surface 12 in., weight 200 lbs/ft. Wall thickness or gauge No. 21 17
 TYPE OF SCREEN OR PERFORATION MATERIAL: PVC
 SCREEN OR PERFORATION OPENINGS ARE: SAW CUT

SCREEN PERFORATED INTERVALS: From 120 ft. to 180 ft., From 0 ft. to 0 ft.
 From 460 ft. to 520 ft., From 0 ft. to 0 ft.
 GRAVEL PACK INTERVALS: From 25 ft. to 240 ft., From 0 ft. to 0 ft.
 From 265 ft. to 525 ft., From 0 ft. to 0 ft.

6 GROUT MATERIAL BENTONITE
 Grout Intervals: From 5 ft. to 25 ft., From 240 ft. to 265 ft., From 0 ft. to 0 ft.
 What is the nearest source of possible contamination: NONE
 Direction from well? How many feet? 0

FROM	TO	LITHOLOGIC LOG	FROM	TO	PLUGGING INTERVALS
0	20	01 TOPSOIL 32 TAN CLAY 21 Limestone			
20	40	21 Limestone 32 TAN CLAY 11 BROWN CLAY			
40	100	36 BLUE CLAY			
100	120	16 GRAY CLAY 26 RED CLAY			
120	140	16 GRAY CLAY 26 RED CLAY 29 SANDSTONE			
140	160	16 GRAY CLAY 29 SANDSTONE 19 LAYERS			
160	200	26 RED CLAY 16 GRAY CLAY			
200	240	16 GRAY CLAY 29 SANDSTONE 19 LAYERS			
240	280	16 GRAY CLAY 26 RED CLAY			
280	300	16 GRAY CLAY 26 RED CLAY 29 SANDSTONE			

7 CONTRACTOR'S OR LANDOWNER'S CERTIFICATION: This water well was Constructed under my jurisdiction and was completed on (mo/day/year) 04/06/06 and this record is true to the best of my knowledge and belief. Kansas Water Well Contractor's License No. 179 This Water Well Record was completed on (mo/day/yr) 05/01/06 under the business name of JOB'S WELL SERVICE, INC. by (signature) *Judith Cude*

(Continued)

WATER WELL RECORD Form WWC-5 KSA 82a-1212

1 LOCATION OF WATER WELL: Fraction Section Number Township Number Range Number
COUNTY: HODGEMAN NW 1/4 SE 1/4 SE 1/4 35 T 22 S R 23 EW

2 WATER WELL OWNER: SIMPSON, TOMMY
RR#, St. Address, Box #: 2254 STARFIELD PL. Board of Agriculture, Division of Water Resources
City, State, ZIP code : HOT SPRINGS, AK 71913- Application Number:

FROM	TO	LITHOLOGIC LOG
300	320	29 SANDSTONE 16 GRAY CLAY
320	340	16 GRAY CLAY 08 ROCK LAYERS
340	360	16 GRAY CLAY
360	440	29 SANDSTONE
440	480	29 SANDSTONE 07 BLUE SHALE
480	520	29 SANDSTONE
520	540	11 BROWN CLAY

7 CONTRACTOR'S OR LANDOWNER'S CERTIFICATION: This water well was Constructed under my jurisdiction and was completed on (mo/day/year) 04/06/06 and this record is true to the best of my knowledge and belief. Kansas Water Well Contractor's License No. 179 This Water Well Record was completed on (mo/day/yr) 05/01/06 under the business name of JOB'S WELL SERVICE, INC. by (signature) *Jessie Cook*