


WATER WELL RECORD Form WWC-5 KSA 82a-1212

1 LOCATION OF WATER WELL: Fraction Section Number Township Number Range Number  
 COUNTY: HODGEMAN NE 1/4 NW 1/4 NW 1/4 33 T 22 S R 23 NW

Distance and direction from nearest town or city street address of well if located within city?  
 FROM JETMORE ON HIGHWAY 156 - 2 EAST & 1 NORTH

2 WATER WELL OWNER: TARMAN, J.D.  
 RR#, St. Address, Box #: BOX 594 Board of Agriculture, Division of Water Resources  
 City, State, ZIP code: JETMORE, KS 67854- Application Number:

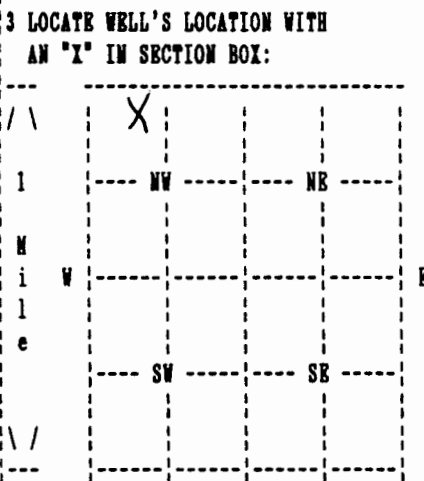

4 DEPTH OF COMPLETED WELL 485 ELEVATION: 0  
 Depth(s) Groundwater Encountered 1. 0 ft. 2. 0 ft. 3. 0 ft.  
 WELL'S STATIC WATER LEVEL 112 ft. below land surface measured on no/day/yr 02/09/06  
 Pump testdata: Well water was 0 ft. after 0 hours pumping 0 gpm  
 Estimated Yield 35 gpm: Well water was 0 ft. after 0 hours pumping 0 gpm  
 Bore Hole Diameter 10 in. to 485 ft., and in. to 0 ft.  
 WELL WATER TO BE USED AS: DOMESTIC  
 Was a chemical/bacteriological sample submitted to department? No ;  
 If yes, no/day/yr sample was submitted Water well disinfected? Yes

5 TYPE OF BLANK CASING USED: CERTA LOC CASIN CASING JOINTS: CERTA-LOC  
 Blank casing diameter 5 in. to 485 ft., Dia in. to 0 ft., Dia in. to 0 ft.  
 Casing height above land surface 12 in., weight 200 lbs/ft. Wall thickness or gauge No. 21 17  
 TYPE OF SCREEN OR PERFORATION MATERIAL: PVC  
 SCREEN OR PERFORATION OPENINGS ARE: SAW CUT

SCREEN PERFORATED INTERVALS: From 380 ft. to 480 ft., From 0 ft. to 0 ft.  
 From 0 ft. to 0 ft., From 0 ft. to 0 ft.  
 GRAVEL PACK INTERVALS: From 25 ft. to 485 ft., From 0 ft. to 0 ft.  
 From 0 ft. to 0 ft., From 0 ft. to 0 ft.

6 GROUT MATERIAL BENTONITE  
 Grout Intervals: From 5 ft. to 25 ft., From 0 ft. to 0 ft., From 0 ft. to 0 ft.  
 What is the nearest source of possible contamination: NONE  
 Direction from well? How many feet? 0

FROM	TO	LITHOLOGIC LOG	FROM	TO	PLUGGING INTERVALS
0	20	01 TOPSOIL 32 TAN CLAY			
20	40	32 TAN CLAY 02 FINE SAND 21 LIMESTONE <i>layers</i>			
40	60	21 LIMESTONE 37 FIN-COAR SAN 07 BLUE SHALE			
60	120	07 BLUE SHALE 24 THINROCLAYER			
120	180	36 BLUE CLAY 24 THINROCLAYER			
180	340	16 GRAY CLAY 24 THINROCLAYER 29 SANDSTONE			
340	440	29 SANDSTONE			
440	460	29 SANDSTONE 36 BLUE CLAY			
460	480	36 BLUE CLAY 29 SANDSTONE 24 THINROCLAYER			
480	500	29 SANDSTONE			

7 CONTRACTOR'S OR LANDOWNER'S CERTIFICATION: This water well was Constructed under my jurisdiction and was completed on (no/day/year) 02/10/06 and this record is true to the best of my knowledge and belief. Kansas Water Well Contractor's License No. 179 This Water Well Record was completed on (no/day/yr) 03/02/06 under the business name of JOB'S WELL SERVICE, INC. by (signature) *Janet Crick*