


WATER WELL RECORD Form WWC-5 KSA 82a-1212

1 LOCATION OF WATER WELL: Fraction Section Number Township Number Range Number
 COUNTY: HODGEMAN NE 1/4 SE 1/4 NE 1/4 31 T 22 S R 23 *EW*

Distance and direction from nearest town or city street address of well if located within city?
 FROM JETMORE JCT. 156 & 283 - 1 MILE EAST & 3/4 NORTH

2 WATER WELL OWNER: RUDZIK, LLOYD Board of Agriculture, Division of Water Resources
 RR#, St. Address, Box #: PO BOX 655 Application Number:
 City, State, ZIP code: JETMORE, KS 67854-

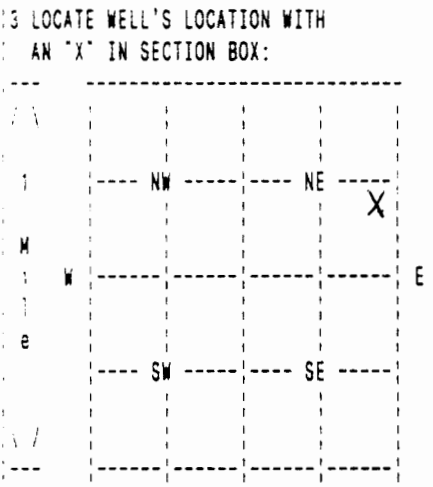

4 DEPTH OF COMPLETED WELL 375 ELEVATION: 0
 Depth(s) Groundwater Encountered 1. 0 ft. 2. 0 ft. 3. 0 ft.
 WELL'S STATIC WATER LEVEL 129 ft. below land surface measured on mo/day/yr 03/25/07
 Pump testdata: Well water was 0 ft. after 0 hours pumping 0 gpm
 Estimated Yield 45 gpm: Well water was 0 ft. after 0 hours pumping 0 gpm
 Bore Hole Diameter 9 in. to 375 ft., and in. to 0 ft.
 WELL WATER TO BE USED AS: DOMESTIC
 Was a chemical/bacteriological sample submitted to department? No ;
 If yes, mo/day/yr sample was submitted Water well disinfected? Yes

5 TYPE OF BLANK CASING USED: CERTA LOC CASIN CASING JOINTS: CERTA-LOC
 Blank casing diameter 5 in. to 375 ft., Dia in. to 0 ft., Dia in. to 0 ft.
 Casing height above land surface 12 in., weight 200 lbs/ft. Wall thickness or gauge No. 21 17
 TYPE OF SCREEN OR PERFORATION MATERIAL: PVC
 SCREEN OR PERFORATION OPENINGS ARE: SAW CUT

SCREEN PERFORATED INTERVALS: From 309 ft. to 369 ft., From 0 ft. to 0 ft.
 From 0 ft. to 0 ft., From 0 ft. to 0 ft.
 GRAVEL PACK INTERVALS: From 26 ft. to 375 ft., From 0 ft. to 0 ft.
 From 0 ft. to 0 ft., From 0 ft. to 0 ft.

6 GROUT MATERIAL BENTONITE
 Grout Intervals: From 5 ft. to 26 ft., From 0 ft. to 0 ft., From 0 ft. to 0 ft.
 What is the nearest source of possible contamination: ABANDONED WELL
 Direction from well? NORTH How many feet? 90

FROM	TO	LITHOLOGIC LOG	FROM	TO	PLUGGING INTERVALS
0	20	01 TOPSOIL 32 TAN CLAY 21 LIMESTONE			
20	40	21 LIMESTONE 19 LAYERS 07 BLUE SHALE			
40	160	07 BLUE SHALE			
160	180	07 BLUE SHALE 36 BLUE CLAY 29 SANDSTONE			
180	200	36 BLUE CLAY 29 SANDSTONE 19 LAYERS			
200	240	16 GRAY CLAY 29 SANDSTONE 19 LAYERS			
240	380	29 SANDSTONE			

7 CONTRACTOR'S OR LANDOWNER'S CERTIFICATION: This water well was Constructed under my jurisdiction and was completed on (mo/day/year) 03/30/07 and this record is true to the best of my knowledge and belief. Kansas Water Well Contractor's License No. 179 This Water Well Record was completed on (mo/day/yr) 04/19/07 under the business name of JOE'S WELL SERVICE, INC. by (signature) *Judith Cook*