


WATER WELL RECORD Form WWC-5 KSA 82a-1212

1 LOCATION OF WATER WELL: ; Fraction ; Section Number ; Township Number ; Range Number
 COUNTY: 042 HODGEMAN ; NW 1/4 NW 1/4 NW 1/4 ; 14 ; T 22 S ; R 24 W

Distance and direction from nearest town or city street address of well if located within city?
 FROM JETMORE, 4 MILES NORTH, 2 MILES WEST, 1/2 MILE SOUTH

2 WATER WELL OWNER: CLARE SHRIWISE
 RR#, St. Address, Box #: 1806 1/2 FAIRWAY DRIVE Board of Agriculture, Division of Water Resources
 City, State, ZIP code : DODGE CITY, KS 67801- Application Number: 14,019

3 LOCATE WELL'S LOCATION WITH AN "X" IN SECTION BOX: ; 4 DEPTH OF COMPLETED WELL 557 ELEVATION: 0
 Depth(s) Groundwater Encountered 1. 0 ft. 2. 0 ft. 3. 0 ft.

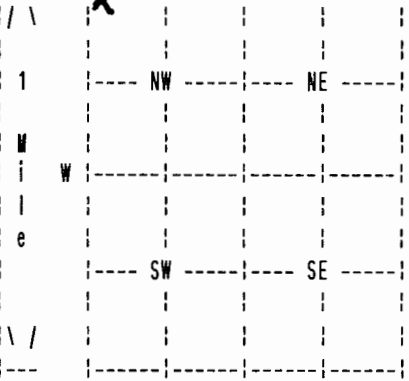

WELL'S STATIC WATER LEVEL 278 ft. below land surface measured on mo/day/yr 02/10/96
 Pump testdata: Well water was 0 ft. after 0 hours pumping 0 gpm
 Estimated Yield 0 gpm: Well water was 0 ft. after 0 hours pumping 0 gpm
 Bore Hole Diameter in. to 0 ft., and in. to 0 ft.

WELL WATER TO BE USED AS: 02 IRRIGATION
 Was a chemical/bacteriological sample submitted to department? No ;
 If yes, mo/day/yr sample was submitted Water well disinfected? Yes

5 TYPE OF BLANK CASING USED: 02 PVC CASING JOINTS: GLUED
 Blank casing diameter 12 in. to 557 ft., Dia in. to 0 ft., Dia in. to 0 ft.
 Casing height above land surface 12 in., weight 15 lbs/ft. Wall thickness or gauge No. .606
 TYPE OF SCREEN OR PERFORATION MATERIAL: 07 PVC
 SCREEN OR PERFORATION OPENINGS ARE: 03 MILL SLOT

SCREEN PERFORATED INTERVALS: From 457 ft. to 557 ft., From 0 ft. to 0 ft.
 From 0 ft. to 0 ft., From 0 ft. to 0 ft.
 GRAVEL PACK INTERVALS: From 20 ft. to 557 ft., From 0 ft. to 0 ft.
 From 0 ft. to 0 ft., From 0 ft. to 0 ft.

6 GROUT MATERIAL 03 BENTONITE
 Grout Intervals: From 0 ft. to 20 ft., From 0 ft. to 0 ft., From 0 ft. to 0 ft.
 What is the nearest source of possible contamination: NONE OBSERVED
 Direction from well? How many feet? 0

FROM	TO	LITHOLOGIC LOG	FROM	TO	PLUGGING INTERVALS
0	6	03 SILTY CLAY			
6	22	01 CLAY			
22	29	07 FINE SAND			
29	54	01 CLAY			
54	100	05 SAND			
100	470	19 SHALE			
470	557	23 SANDSTONE			
557	560	19 SHALE			

7 CONTRACTOR'S OR LANDOWNER'S CERTIFICATION: This water well was Reconstructed under my jurisdiction and was completed on (mo/day/year) 02/10/96 and this record is true to the best of my knowledge and belief. Kansas Water Well Contractor's License No. 145 This Water Well Record was completed on (mo/day/yr) 04/11/96 under the business name of HENKLE DRILLING & SUPPLY by (signature) *Bruce Reichert*