USE TYPEWRITER OR BALL POINT PEN-PRESS FIRMLY, PRINT CLEARLY.

Jetmore

WATER WELL RECORD
KSA 82a-1201-1215

Kansas Department of Health and Environment-Division of Environment
(Water well Contractors)
Topeka, Kansas 66620

DDD

| 1. Location of well: | County | Fraction | Section number | Township number | Range number |
|---|---|---|---|---|---|
| | Hodgeman | Se 1/4 SE 1/4 SE 1/4 | 26 | T 22 S | R 24 E (W) |

2. Distance and direction from nearest town or city: IW, IN of Jetmore
Street address of well location if in city:

3. Owner of well: L. E. Ford
R.R. or street:
City, state, zip code: Jetmore, Kansas 67854

4. Locate with "X" in section below:

N
NW NE
W E
SW SE X
S
1 Mile 1 Mile

Sketch map:

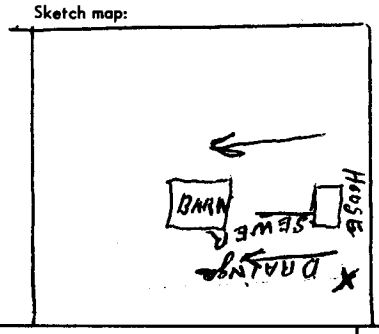


6. Bore hole dia. 8 in. Completion date 4-8-76
Well depth 450 ft.

7. __ Cable tool X Rotary __ Driven __ Dug
__ Hollow rod __ Jetted __ Bored __ Reverse rotary

8. Use: __ Domestic X Public supply __ Industry
__ Irrigation __ Air conditioning __ Stock
__ Lawn __ Oil field water __ Other

9. Casing: Material steel Height: Above or below
Threaded X Welded ___ Surface 12 in.
RMP ___ PVC ___ Weight 11 lbs./ft.
Dia. 4 1/2 in. to 410 ft. depth Wall Thickness: inches or
Dia. ___ in. to ___ ft. depth gage No. 188

10. Screen: Manufacturer's name Doerr
Type Gravel Guard Dia. 4 1/2
Slot/gauze 1/16 Length 40
Set between 410 ft. and 450 ft.
___ ft. and ___ ft.
Gravel pack? X Size range of material 1/4 to 1/8

11. Static water level: mo./day/yr.
170 ft. below land surface Date 3-5-76

12. Pumping level below land surfaces:
200 ft. after 1 hrs. pumping 15 g.p.m.
___ ft. after ___ hrs. pumping ___ g.p.m.
Estimated maximum yield 30 g.p.m.

13. Water sample submitted: mo./day/yr.
__ Yes X No Date

14. Well head completion:
X Pitless adapter 12 Inches above grade

15. Well grouted? Yes
With: __ Neat cement __ Bentonite X Concrete
Depth: From 15 ft. to 3 ft.

16. Nearest source of possible contamination:
ft. 150 Direction N Type sewer
Well disinfected upon completion? X Yes __ No

17. Pump: __ Not installed
Manufacturer's name Aermotor
Model number SD-12 HP 1 1/2 Volts 230
Length of drop pipe 315 ft. capacity 12 g.p.m.
Type:
X Submersible __ Turbine
__ Jet __ Reciprocating
__ Centrifugal __ Other

| 5. Type and color of material | From | To |
|---|---|---|
| 0 Topsoil | 0 | 5 |
| Yellow Clay | 5 | 30 |
| Blue Shale | 30 | 210 |
| White Clay | 210 | 252 |
| Red Clay | 252 | 260 |
| White Clay | 260 | 410 |
| Sand Stone | 410 | 450 |
| BROCK 5' PA | | |
| CRETACEOUS WELL | | |

(Use a second sheet if needed)

18. Elevation:
Topography:
__ Hill
X Slope
__ Upland
__ Valley

19. Remarks:
Concrete slab was installed
TOPO 2357

20. Water well contractor's certification:
This well was drilled under my jurisdiction and this report is true to the best of my knowledge and belief.
Knoefler Bros, Drilling
Business name License No. 130
Address Jetmore,
Signed Dale Knoefler Date 5-10-76
Authorized representative

T 22 R 24 (W) Sec 26 1/4 SE 1/4 SE 1/4 SE 1/4

Forward the white, blue and pink copies to the Department of Health and Environment

Form WWC-5

MI-1023